


T. 41 S., R. 14 1/2 E., W.M.

STONE

DIVERSION IS 2220
FEET SOUTH AND
280 FEET EAST
OF THE N 1/4 CORNER
OF SECTION 1.

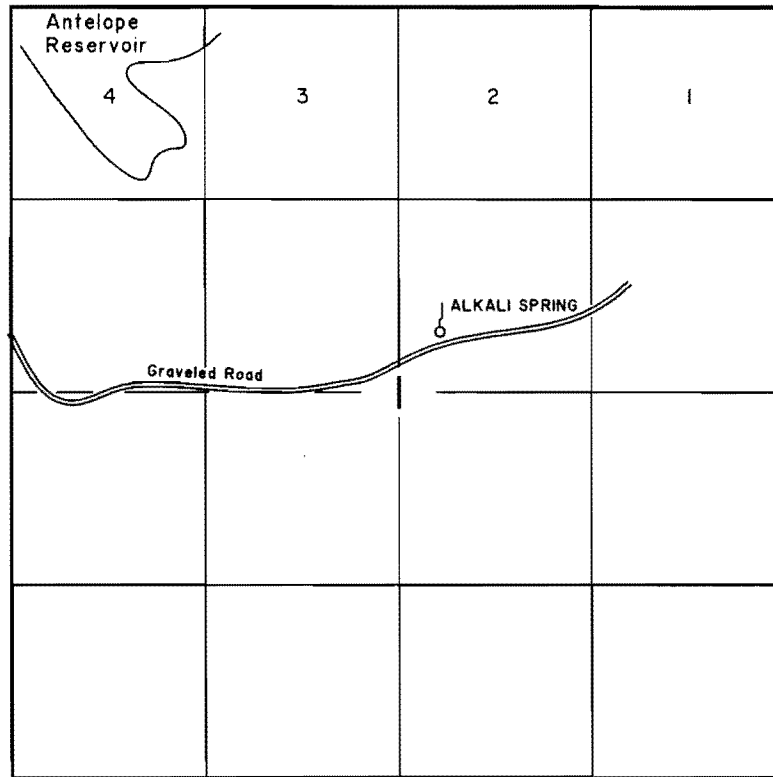

RECEIVED

JAN 15 1999

WATER RESOURCES DEPT.
SALEM, OREGON



1" = 1320'

TRANSFER MAP

FOR


ALKALI SPRING

IN NAME OF

UNITED STATES BUREAU OF LAND MANAGEMENT

TRANSFER NO. T-7757

SURVEYED: JUNE 9, 1998

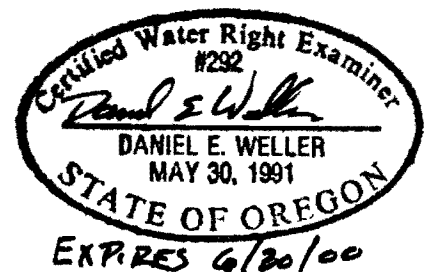

THE PURPOSE OF THIS MAP IS FOR IDENTIFYING THE LOCATION OF THE WATER RIGHT ONLY AND
IS NOT INTENDED TO PROVIDE LEGAL DIMENSIONS OR LOCATION OF PROPERTY OWNERSHIP LINES.

U.S. BUREAU OF LAND MANAGEMENT-OSO
BRANCH OF GEOGRAPHIC SCIENCES

DWG: ALKALI

EXECUTED BY:
DANIEL E. WELLER, PLS, CWRE
P.O. BOX 2965
PORTLAND, OREGON 97208