


T. 39 S., R. 5 E., W.M.

RECEIVED

JAN 15 1999

DIVERSION IS 430
FEET SOUTH AND
800 FEET EAST
OF THE N 1/4 CORNER
OF SECTION 13.

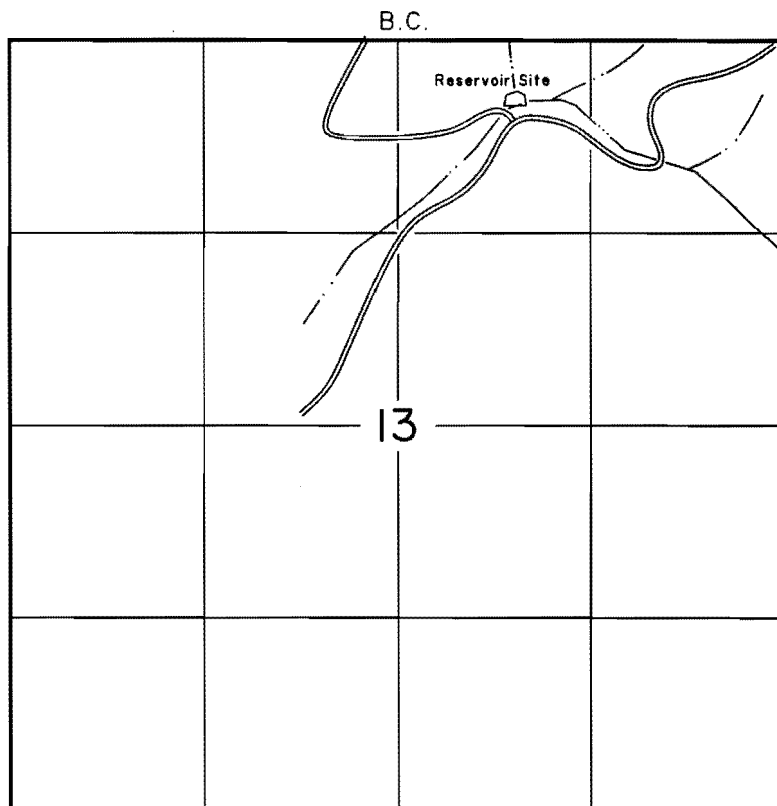

WATER RESOURCES DEPT.
SALEM, OREGON



1" = 1320'

TRANSFER MAP


FOR

ONION SPRINGS PUMP CHANCE

IN NAME OF

UNITED STATES BUREAU OF LAND MANAGEMENT

TRANSFER NO. T-7758

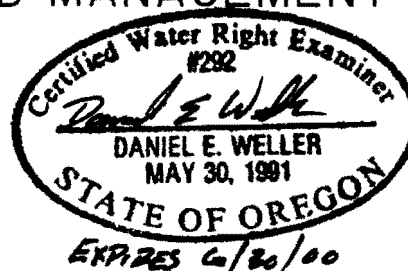

SURVEYED: JUNE 10, 1998

THE PURPOSE OF THIS MAP IS FOR IDENTIFYING THE LOCATION OF THE WATER RIGHT ONLY AND
IS NOT INTENDED TO PROVIDE LEGAL DIMENSIONS OR LOCATION OF PROPERTY OWNERSHIP LINES.

U.S. BUREAU OF LAND MANAGEMENT-OSO
BRANCH OF GEOGRAPHIC SCIENCES

DWG: ONION

EXECUTED BY:
DANIEL E. WELLER, PLS, CWRE
P.O. BOX 2965
PORTLAND, OREGON 97208