

S.17 T.4 S. R.3 E. WILLAMETTE MERIDIAN

CLACKAMAS COUNTY

RECEIVED

SCALE : 1" = 400'

FEB 12 1999

18+17

RECEIVED

MAR 22 1999

WATER RESOURCES DEPT.
SALEM, OREGON

NWSW

* diversion ditch

unnamed stream

pond

house



barn

garage


WATER RESOURCES DEPT.
SALEM, OREGON
TAX LOT 2100

N1/2 NESW

THE POINT OF DIVERSION IS 108' SOUTH, AND
1632' EAST OF THE WEST 1/4 CORNER SEC.17

SWSW

SESW

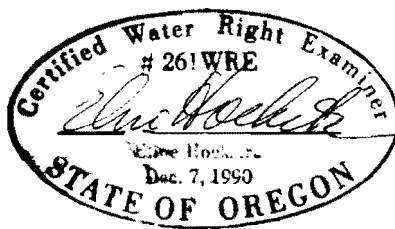

S. BEAVERCREEK ROAD

S. UNGER ROAD

18+17

19+20

NOTE: unnamed stream goes underground.
measurements taken from aerial photos
and on the ground

* The diversion ditch was
constructed in the summer
of 1996

17

20

RECEIVED

MAR 04 1999

WATER RESOURCES DEPT.
SALEM, OREGON

FINAL PROOF SURVEY

UNDER

PERMIT NO. R-11528

IN NAME OF: WAYNE AND PATTY NEWLAND

THE PURPOSE OF THIS MAP IS TO IDENTIFY THE LOCATION OF THE WATER RIGHT
IT IS NOT INTENDED TO PROVIDE INFORMATION RELATIVE TO THE LOCATION OF
THE PROPERTY OWNERSHIP BOUNDARY LINES.