
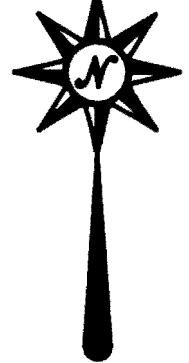


T. 3 S., R. 1 E., WM

RECEIVED

APR 20 1999

WATER RESOURCES DEPT.
SALEM, OREGON

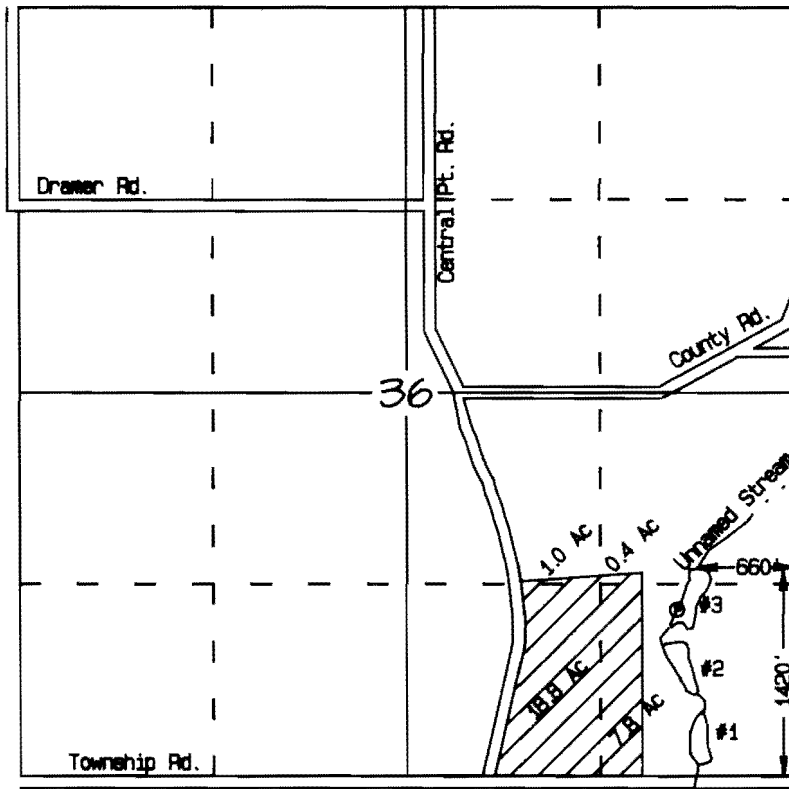

SCALE 1" = 1320'

LEGEND



Area that is
no longer irrigated.



Pump

BENEFICIAL USE REPORT MAP
UNDER

APPLICATION NO. T-7914


PERMIT NO. R-5754 35710

IN NAME OF

Sam & Mary Lou Phipps

7 APRIL 1999

THIS MAP IS FOR THE PURPOSE
OF LOCATING A WATER RIGHT
ONLY AND NOT INTENDED TO
PROVIDE LEGAL DIMENSIONS
OR LOCATIONS OF PROPERTY
OWNERSHIP LINES.

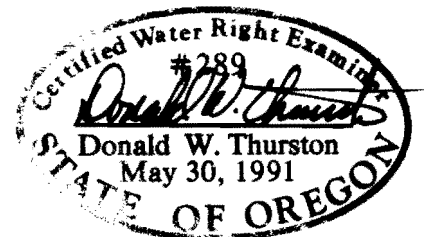

RENEWAL DATE 6/30/00