


# T.41S., R.8E., W.M.

Klamath R. willis

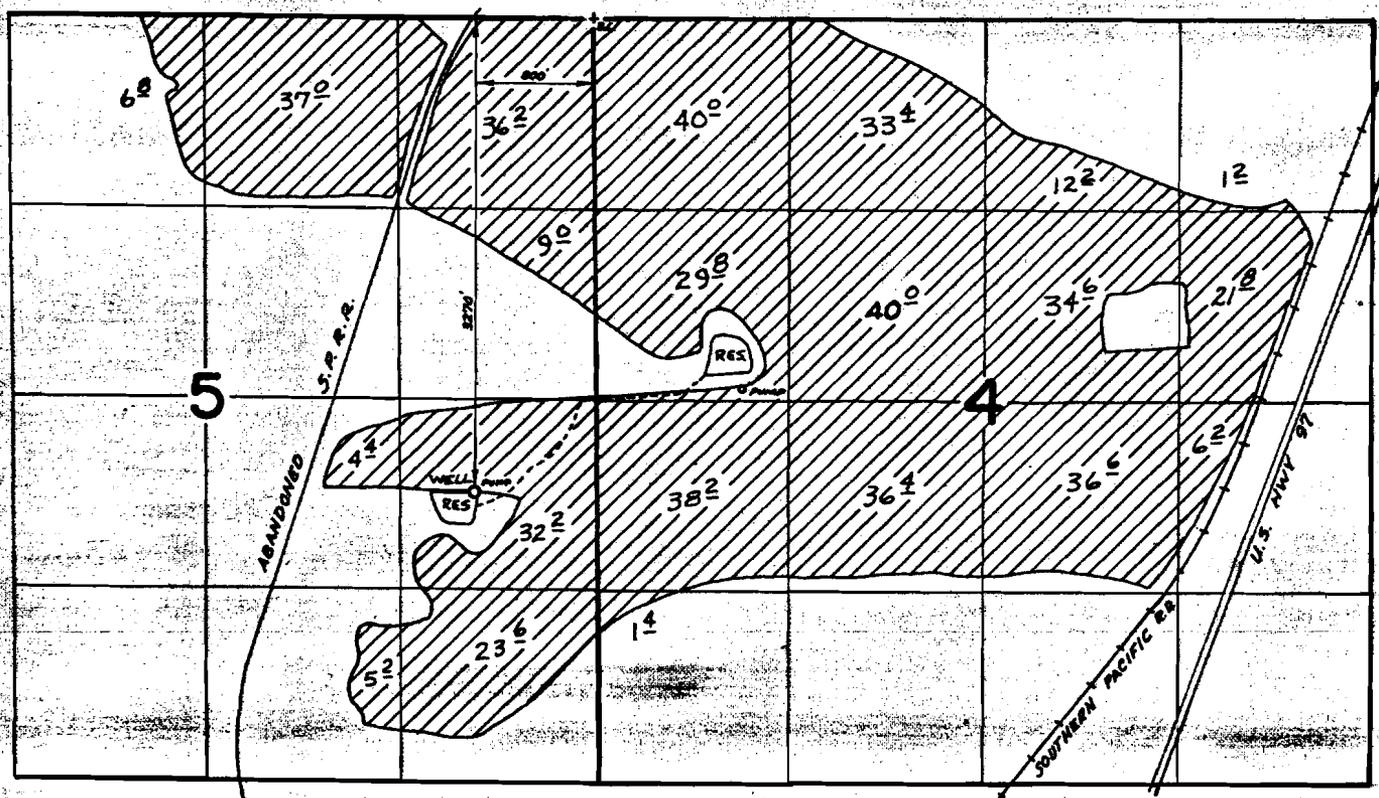

## FINAL PROOF SURVEY UNDER

Application No. G-4835 Permit No. G-4343  
IN NAME OF

CLYDE R., IRENE, WINSTON H. AND LOUISE PATTERSON

Surveyed Oct. 30 1974, by D.M. Norby