


# T.41S., R.8E., W. M.

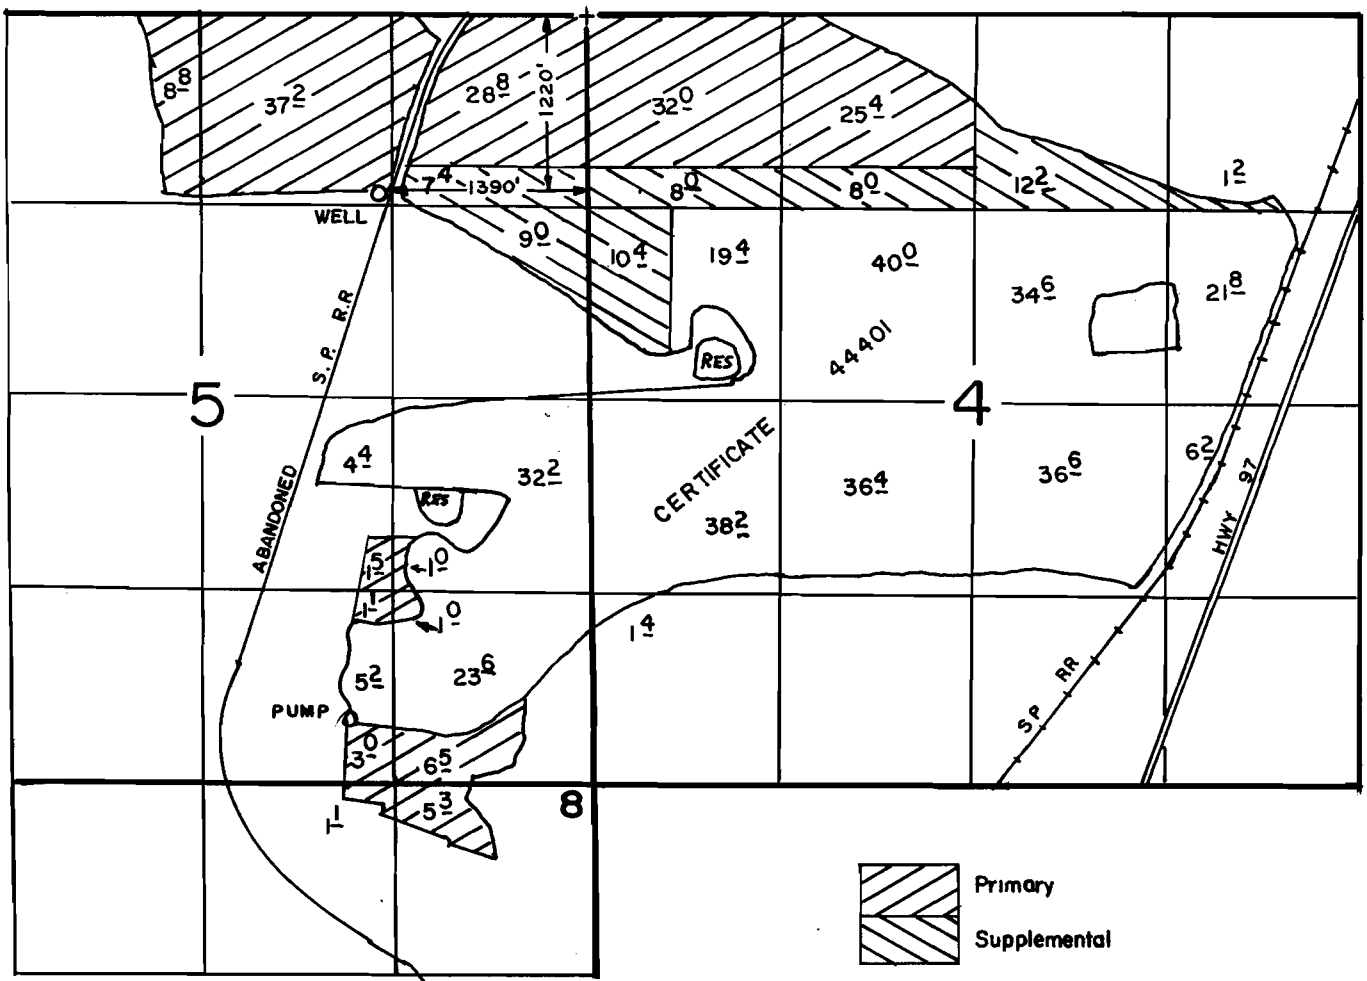

SCALE: 1"=1320'

## FINAL PROOF SURVEY UNDER

Application No. G-8163. [REDACTED].....  
IN NAME OF

..WINSTON.H.&.LOUISE.PATTERSON..

Surveyed AUG.18. 1987., by B.W.BISHOP.....

*Abandoned Sun Wells*