0301

FINAL PROOF MAP
FOR TRANSFER T-9620
STANFIELD HUTTERIAN FARM
PERMIT 37121, AND PERMIT 37833
T4N, R30E WM

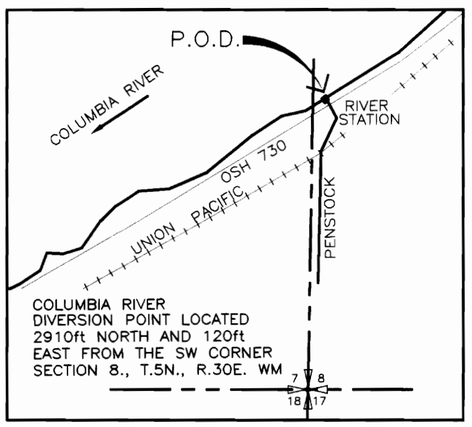

LEGEND

SECTION WHERE CIRCLE IS LOCATED

CIRCLE NUMBER

BOOSTER

CLUSTER NUMBER

T. 5N.
T. 4N.

R. 29E.
R. 30E.

0 1320 2640
SCALE IN FEET

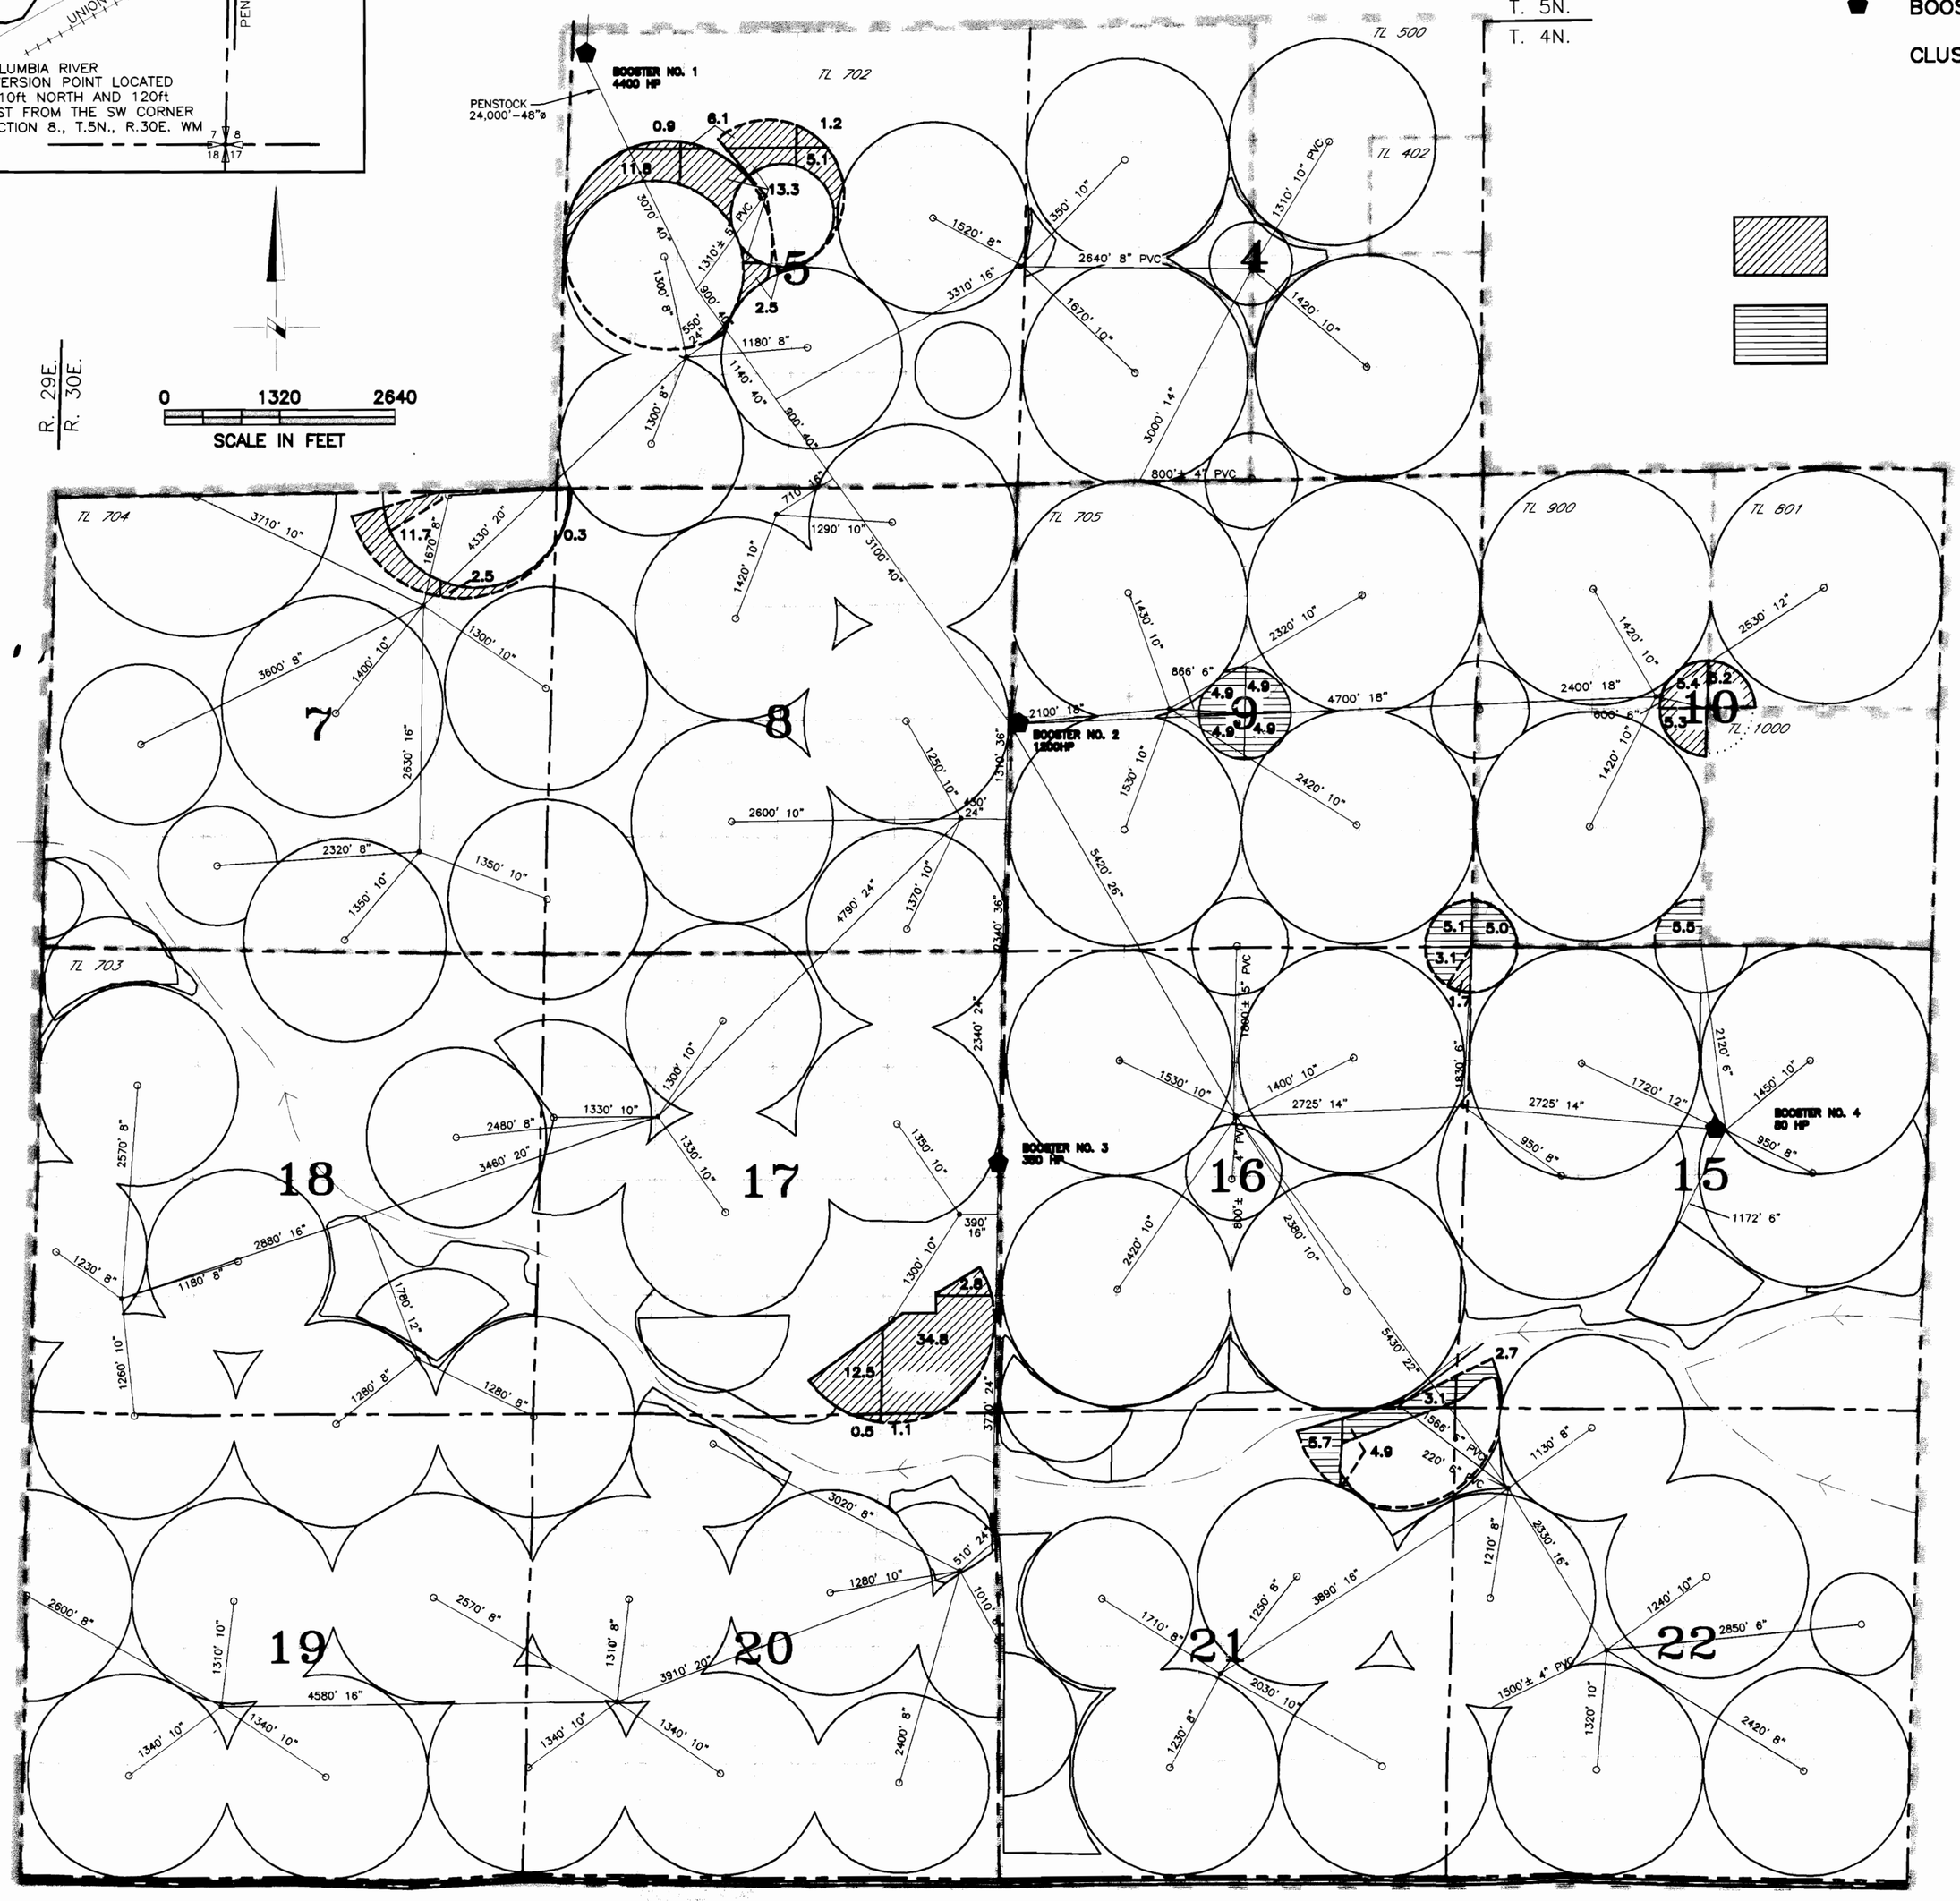

NOTE:
THIS MAP IS FOR THE PURPOSE OF IDENTIFYING THE LOCATION OF THE CENTER PIVOTS ONLY AND IS NOT INTENDED TO PROVIDE LEGAL DIMENSIONS OR LOCATION OF PROPERTY OWNERSHIP LINES. INFORMATION ON THIS MAP HAS BEEN PREPARED USING EXISTING MAPS AND OTHER INFORMATION MADE AVAILABLE BY THE OWNERS AND INFORMATION OBTAINED IN THE FIELD WHERE AVAILABLE.

Certified Water Right Examiner
#339 WRE
Dale G. VanSchoiack
Dale G. VanSchoiack
May 19 1992
9/26/07
STATE OF OREGON

COBU MAP #0301

9/25/07

DRAWING: H:\CAD\AG\3522\178\352217807FP.dwg
PRINTED BY: Roger.Willard on 09/25/07 08:52 AM