



SECTION 10, T.4S, R.1E, W.M.

CLACKAMAS COUNTY, OREGON

RECEIVED

APR 06 2012

WATER RESOURCES DEPT
SALEM, OREGON

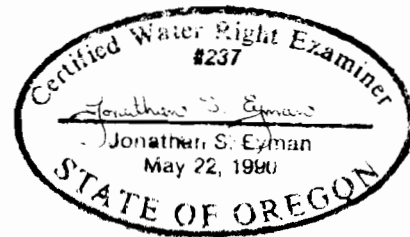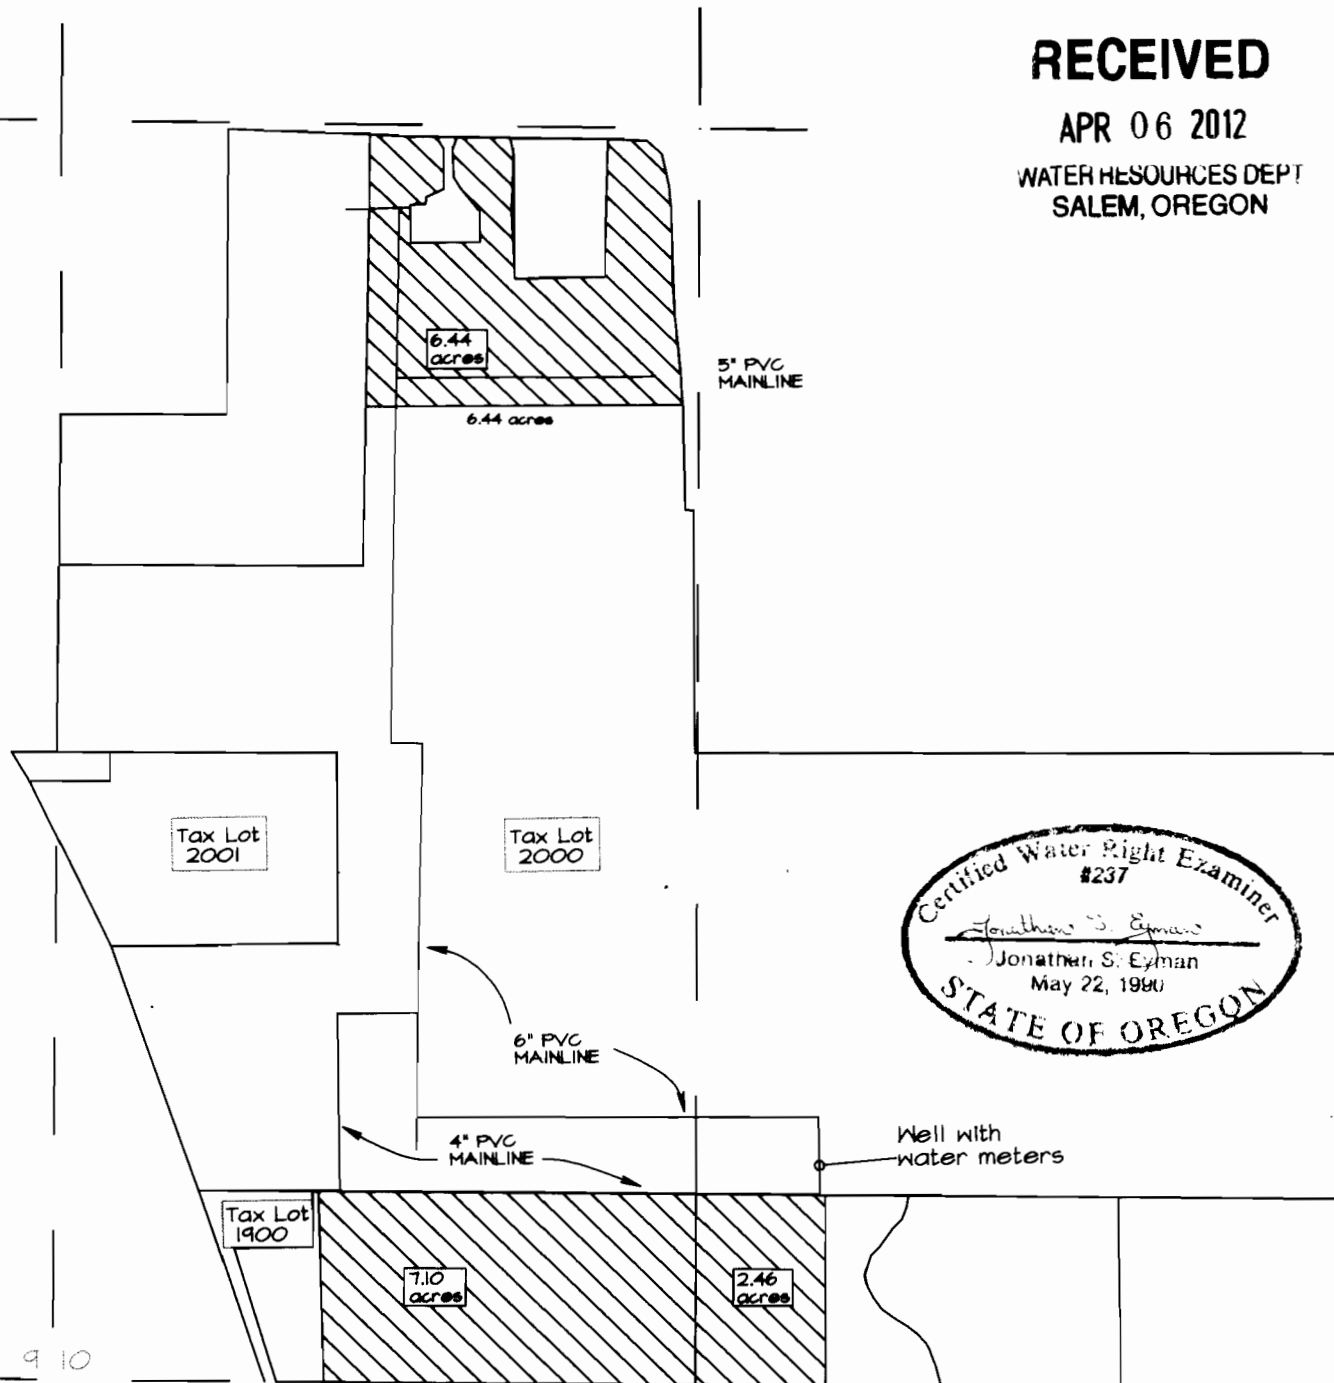

THE WELL IS 1591 FEET EAST AND 454 FEET NORTH OF THE SW CORNER OF SECTION 10
THE WATER METERS ARE LOCATED AT THE WELL.

SCALE: 1" = 400'

CLAIM OF BENEFICIAL USE MAP

ALLEN KRAXBERGER, JR.

APPLICATION NO. G-15582

PERMIT NO. G-15003

PERMIT AMENDMENT NO. T-10843



IRRIGATED AREA
PORTION OF TL 1900
& TL 2000
(16.0 ACRES)

THE PREPARATION OF THIS MAP IS FOR THE
PURPOSE OF IDENTIFYING THE LOCATION
OF THE WATER RIGHT ONLY AND HAS NO
INTENT TO PROVIDE DIMENSIONS OR LOCATION
OF PROPERTY OWNERSHIP LINES

6150101500CLIENT 09/29/2012
2012_G15582_COBU_3 04/08/2012