


# T.3S. R.4W. Sec. 13 & 24, W.M.

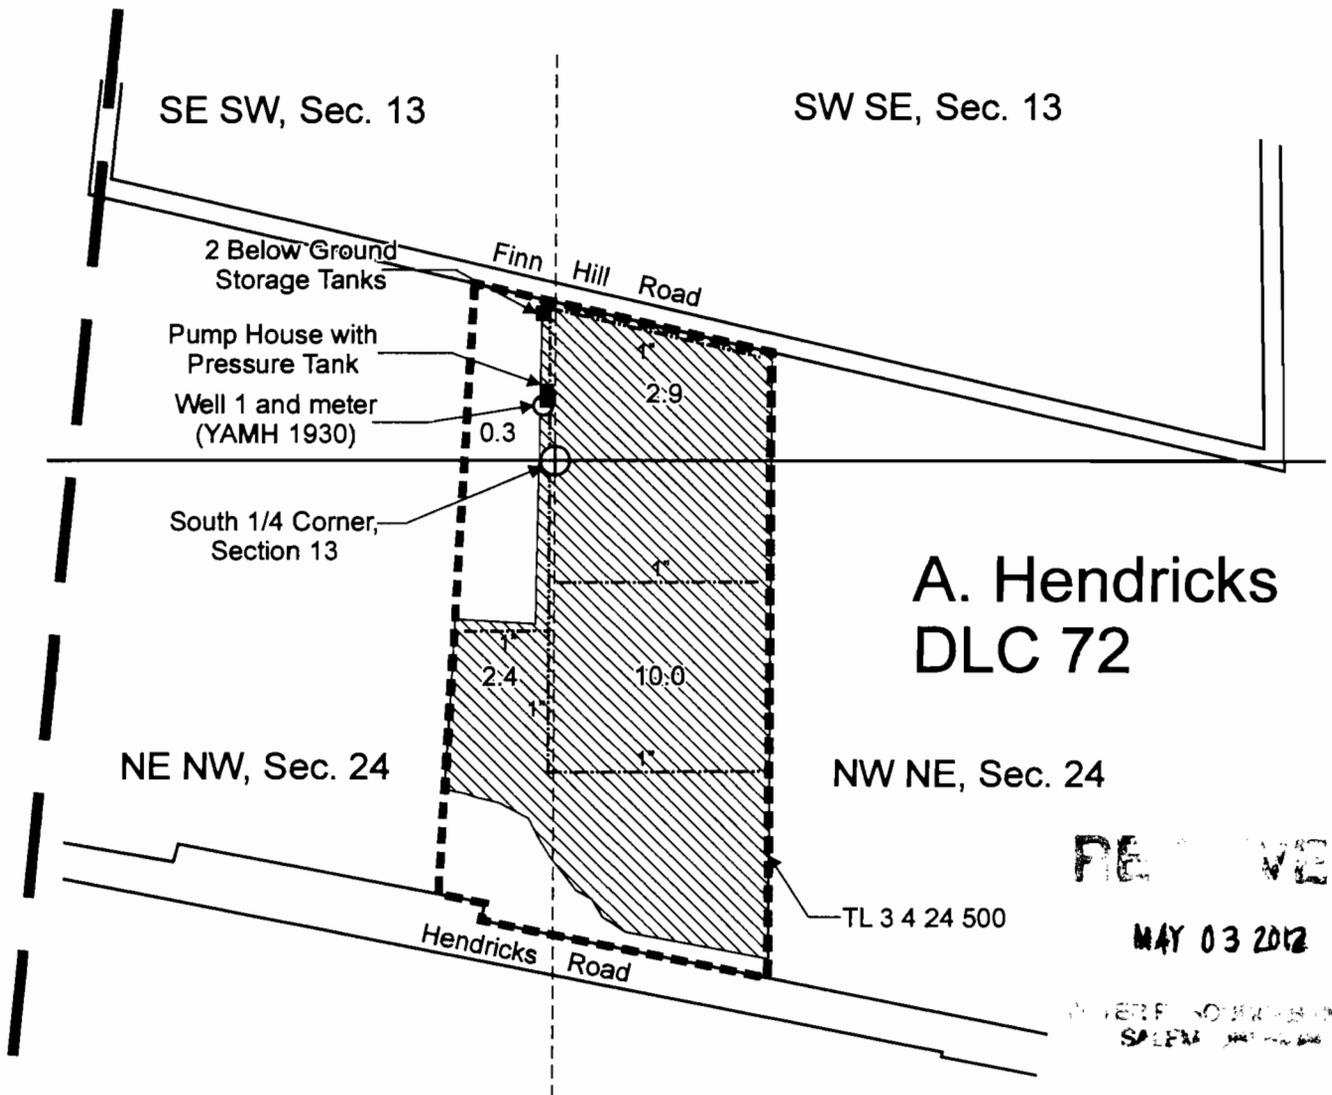

RECEIVED


MAY 03 2012

SALEM

Well 1 (YAMH 1930) is located 120 feet north and 30 feet west from the S 1/4 corner, Section 13.

-  Area (15.6 Acres) irrigated under Application G-17402, Permit G-16813.
-  Tax lot boundary
-  Donation Land Claim Boundary
-  Irrigation main line buried

Scale: 1" = 400'

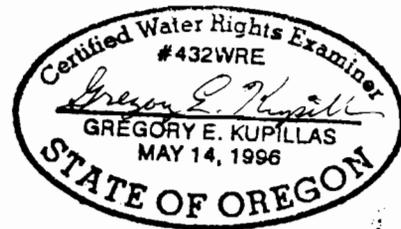

EXPIRATION DATE: 6/30/2013

This map was prepared for the purpose of identifying the location of a water right only and is not intended to provide legal dimensions or location of property ownership lines.

Claim of Beneficial Use Map  
Application G-17402, Permit G-16813

Earl Lumpkins  
T.3S. R.4W. Sec. 13 & 24, W.M.

Pacific Hydro-Geology Inc.

04/2012

LumpkinsCOBUMap.cdr