


CLAIM OF BENEFICIAL USE MAP

TAX LOT 300 SECTION 31, T6S, R5W, WM
POLK COUNTY, OREGON
WILLAMETTE RIVER BASIN

APPLICATION # R-87647
PERMIT # R-14923

PREPARED FOR:
Mike Buhler
5125 Enterprise Road,
Dallas, OR 97338

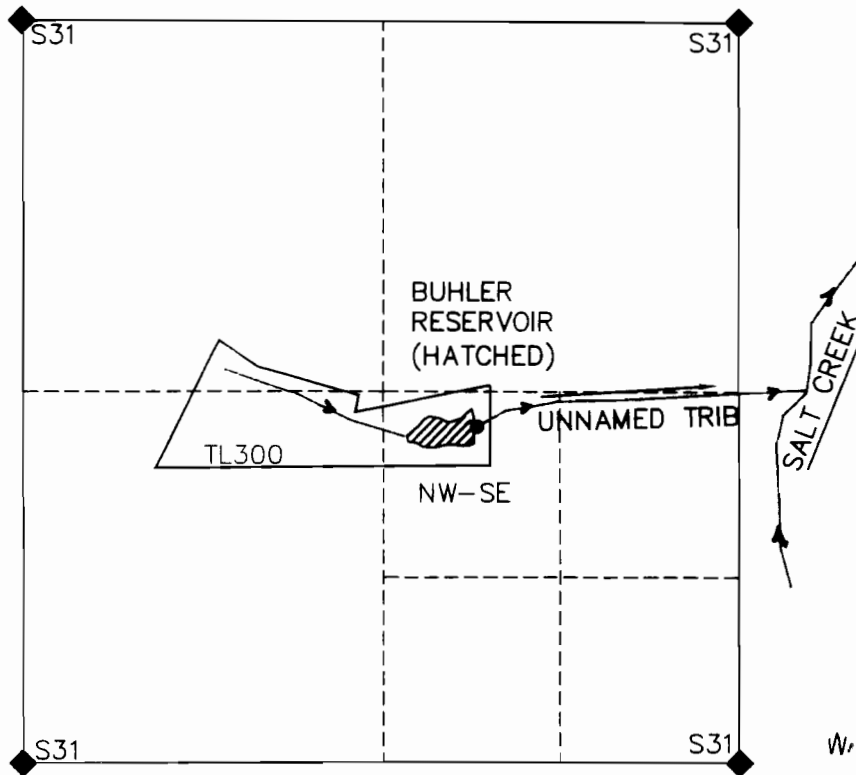

March 9 2012
RECEIVED
[Stamp]


W. ERHESD
S. EM O-F

LEGEND:

- ◆ SECTION CORNER OR 1/4 CORNER
- POINT OF DIVERSION (DAM) IS LOCATED 2980 FT SOUTH AND 3350 FT EAST OF THE NW CORNER OF S31. STAFF GAGE IS MOUNTED ON TRASH RACK FOR RESERVOIR OUTLET.



THIS MAP WAS PREPARED FOR THE PURPOSE OF IDENTIFYING THE LOCATION OF A WATER RIGHT ONLY AND IS NOT INTENDED TO PROVIDE LEGAL DIMENSIONS OR LOCATION OF PROPERTY OWNERSHIP LINES.

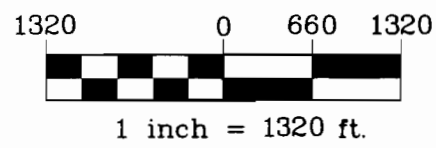

MAP BASE:
POLK COUNTY TAX MAP S31, T6S,
65W AND ORMAP GIS AERIAL PHOTO



Project: 311-2-093
Drawing: 3113093B.dwg
By: EAU
Checked by: EAU
Date: 22FEB2012