
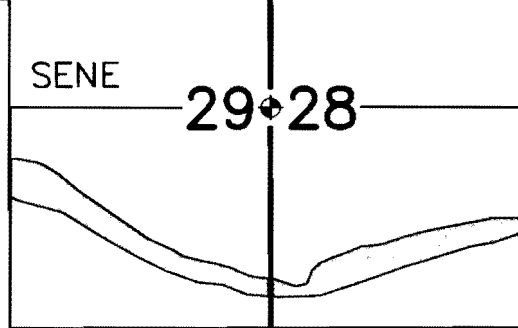
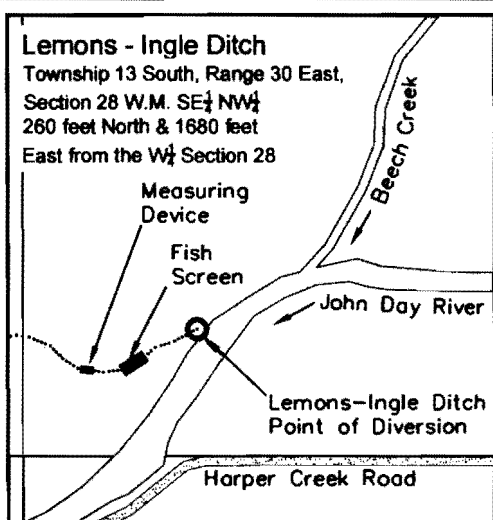
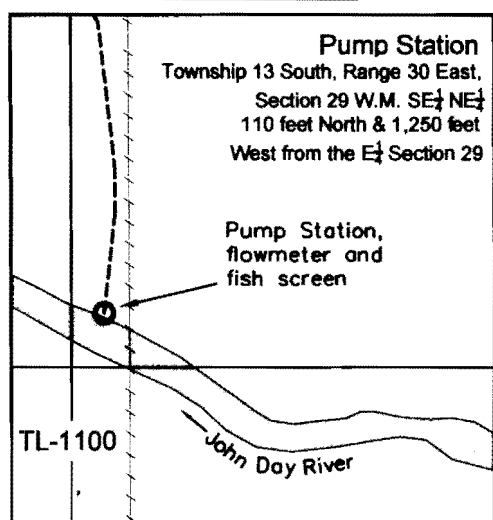


FINAL PROOF SURVEY

Kim Lemons

Transfer No. 10404


Township 13 South, Range 30 East, Section 29 W.M.

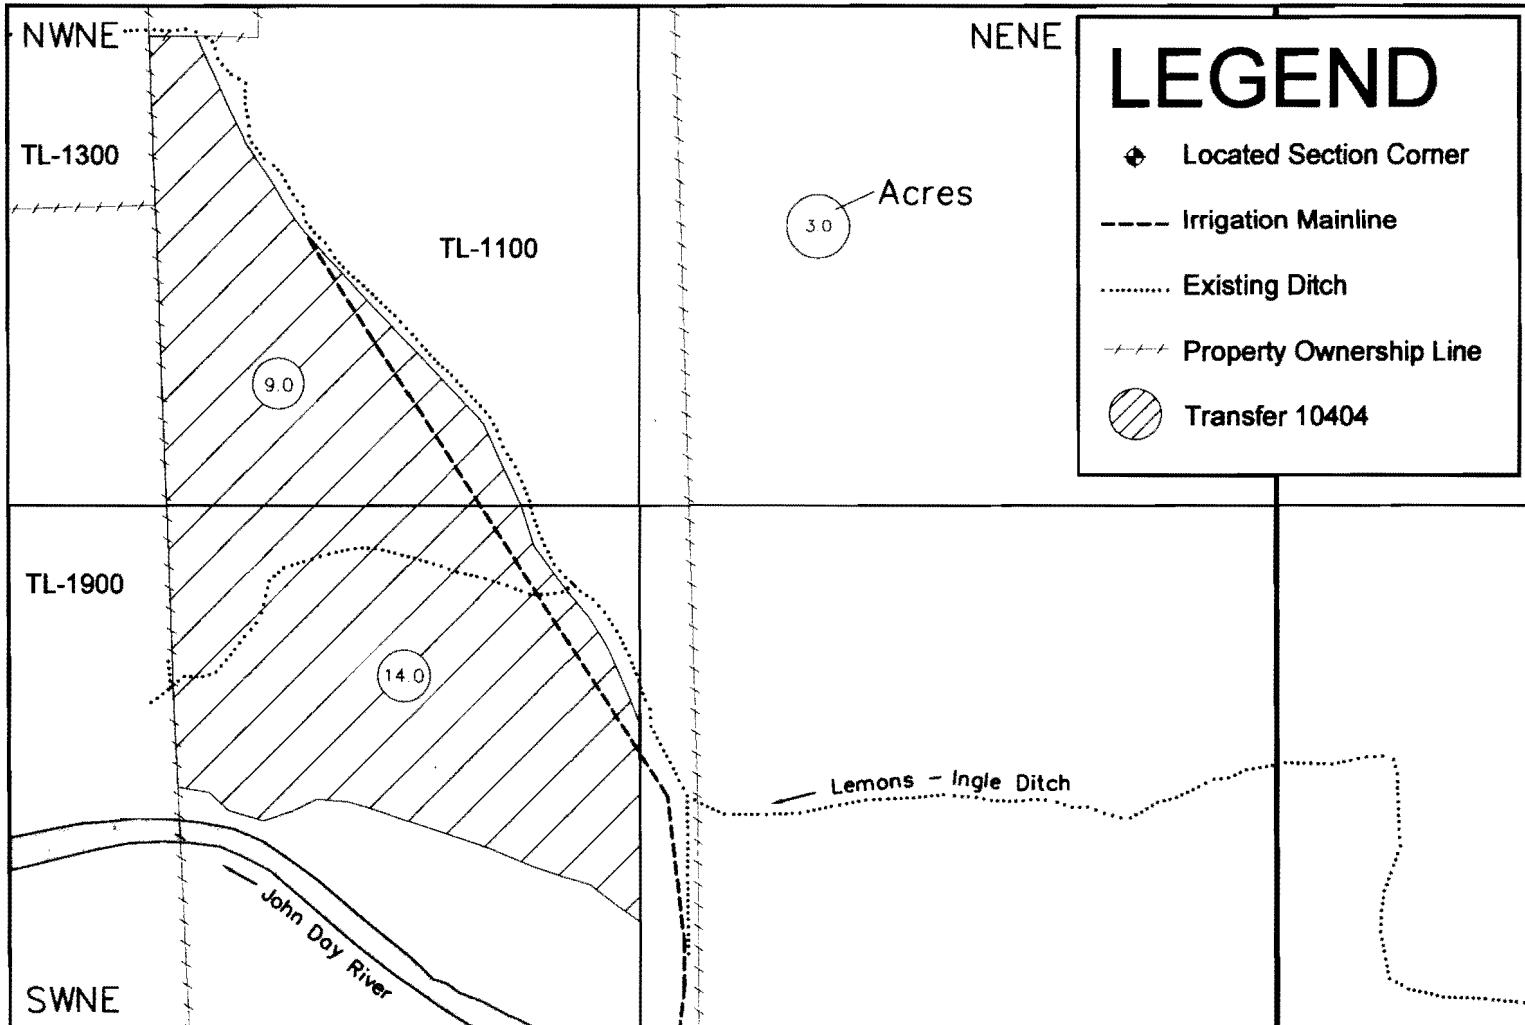

Scale: 1" = 400'

This map is not intended to provide legal dimensions or location of property ownership lines.

REVISED: August 2, 2012

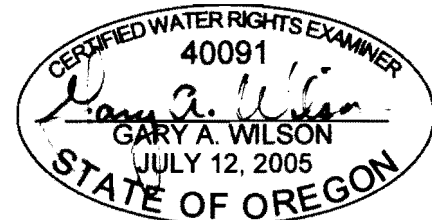

EXPIRES: 6/30/14