




# Claim of Beneficial Use - Well Location Map

## Application G-14247; Permit G-12886


City of Klamath Falls  
Klamath County, Oregon

Section 6, Township 39 South, Range 10 East (W.M.)

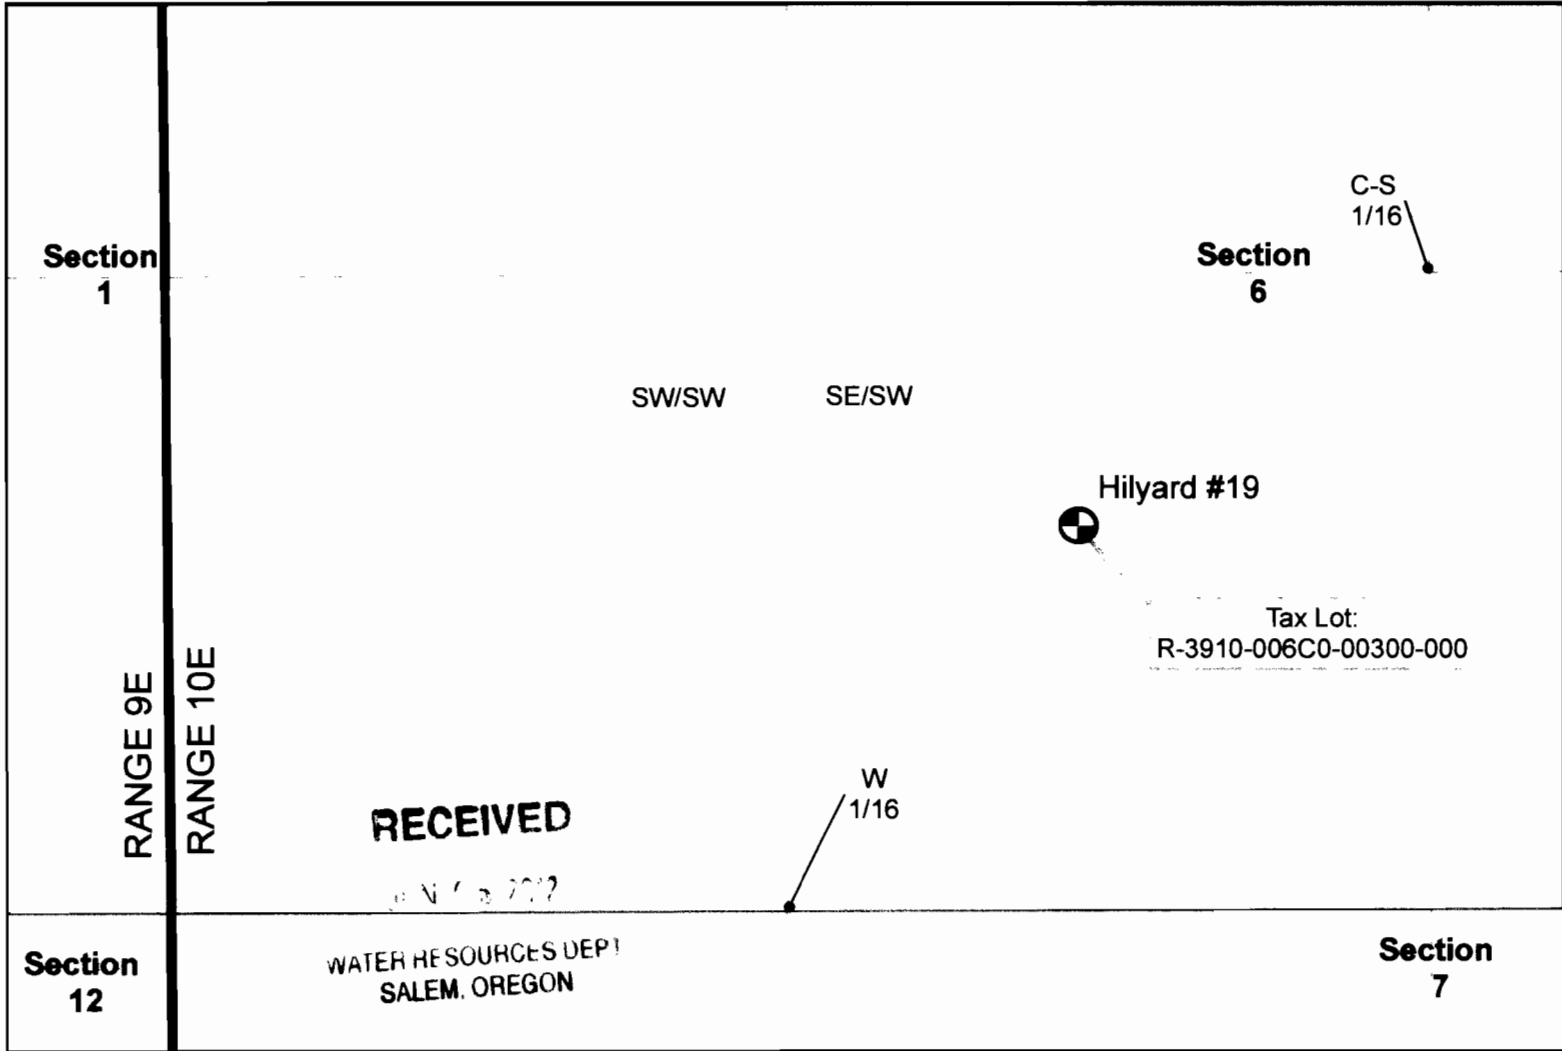

### Legend

- Hilyard 19
- Section Line
- Tax Lot
- 1/4 Section Line
- Township/Range

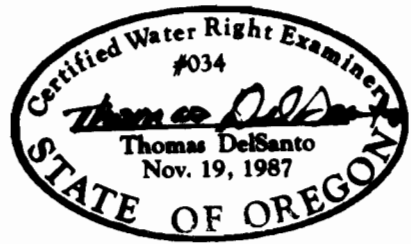

**Map Information**  
 Projection: OCRS Bend-Klamath Falls Zone  
 Datum: North American Datum of 1983  
 Date: February 27, 2012  
 Prepared by: City of Klamath Falls

**Data Sources**  
 City of Klamath Falls



### NOTES:

- 1) Water meter is located 18 feet from the discharge head inside the well house
- 2) Conveyance System: Refer to the system overview map in Attachment 1.


**Disclaimer**  
 This map was prepared for the purpose of identifying the location of a water right only and is not intended to provide legal dimensions or location of property ownership lines.

### POA Location Description

Hilyard Well 19  
 Located 809 Feet North and 607 Feet East from W 1/16 corner between Sections 6 & 7, Township 39 South, Range 10 East (W.M.)

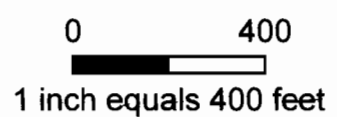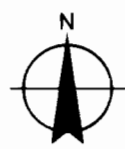

Claim of Beneficial Use  
 Place of Use Map  
 Application G-14247  
 Permit G-12886  
 City of Klamath Falls  
 Klamath County, Oregon

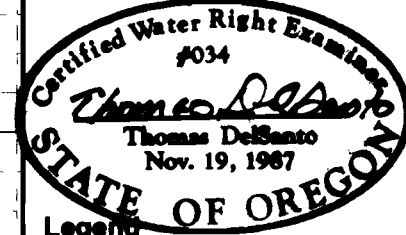

Legend

- Point of Appropriation (POA)
- Place of Use: Permit G-12886

Map Information

Projection: OCRS Bend-Klamath Falls Zone  
 Datum: North American Datum of 1983  
 Date: February 27, 2012  
 Prepared by: City of Klamath Falls

Data Sources



City of Klamath Falls

Disclaimer

This map was prepared for the purpose of identifying the location of a water right only and is not intended to provide legal dimensions or location of property ownership lines.

0 3,250 6,500


1 inch equals 6,500 feet

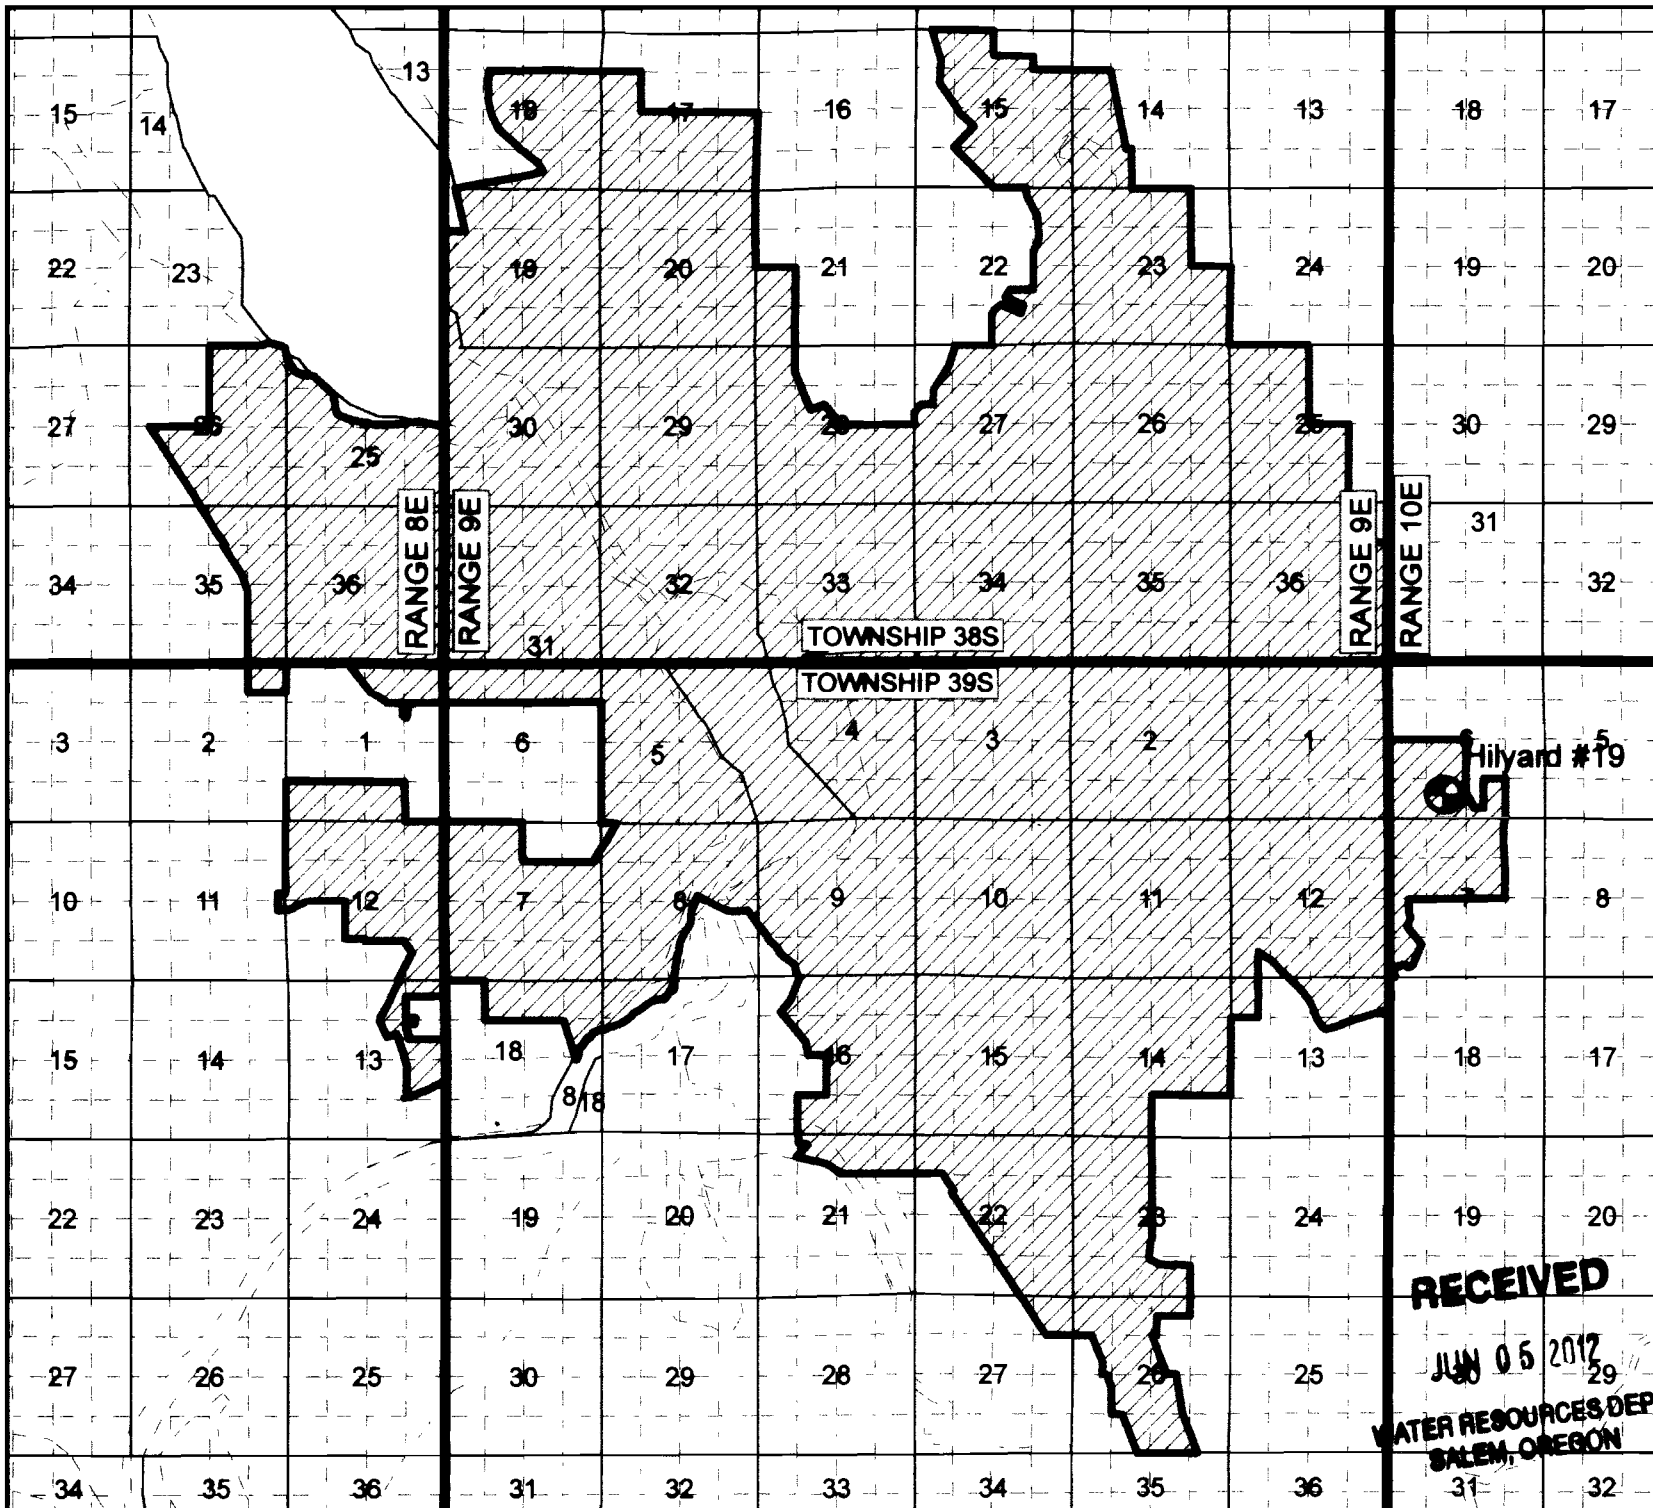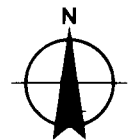

**RECEIVED**

JUN 05 2012  
 WATER RESOURCES DEPT  
 SALEM, OREGON

# City of Klamath Falls System Overview Map

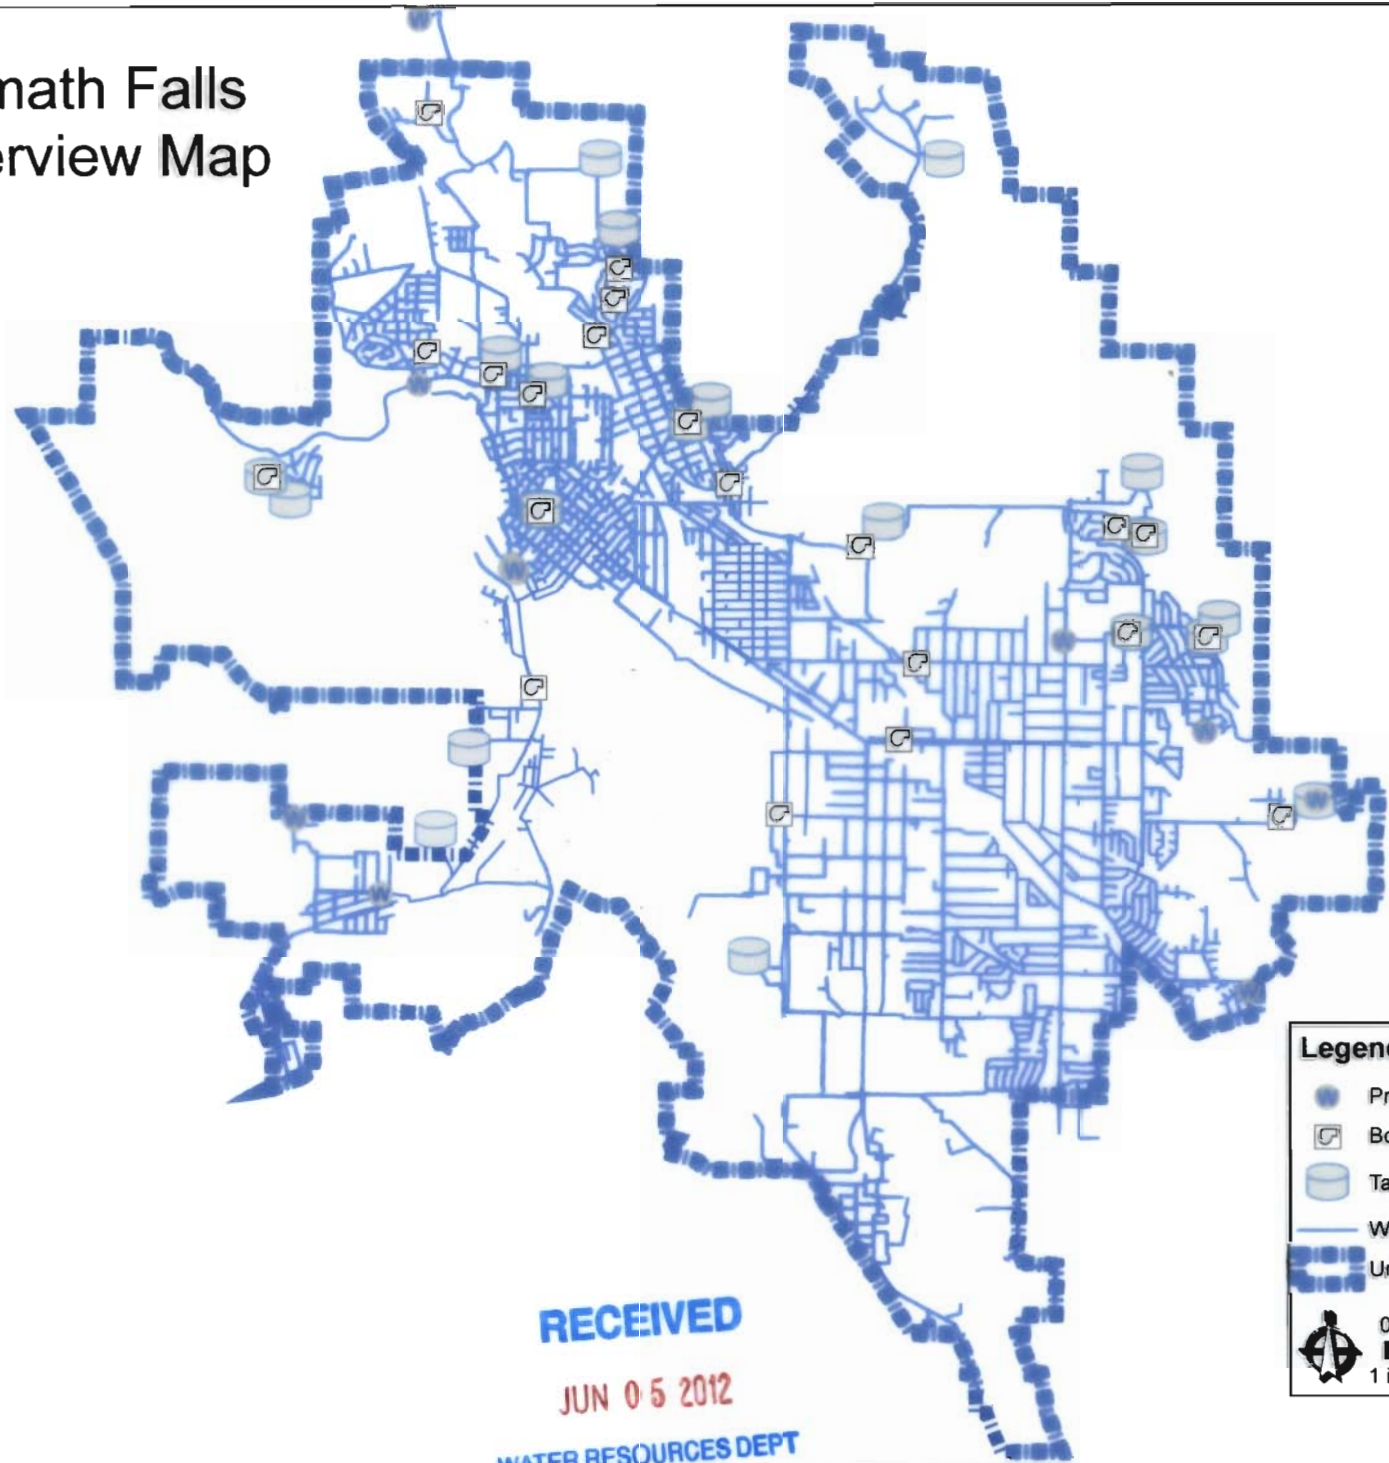

**RECEIVED**

**JUN 05 2012**

**WATER RESOURCES DEPT  
SALEM, OREGON**

**Legend**

- Production Well
- Booster Pump Station
- Tank/Reservoir
- Water Main Pipeline
- Urban Growth Boundary

0 3,250 6,500  
1 inch equals 4,800 feet