


CLAIM OF BENEFICIAL USE MAP
NW 1/4 Section 24, T.29S. R.17E., W.M.
Lake County, Oregon

Application G-14315
 Permit G-13246

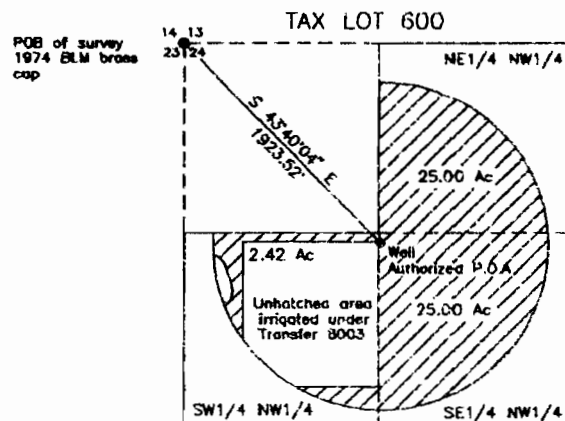


SCALE
 1" = 1320'



52.42 Acres irrigated
 Permit G-13246

Prepared for: Ernest D. & Dixie Shuffield
 Prepared by: Sundet & Associates
 P.O. Box 1228
 Lakeview, OR 97630

March 2004 DR #17204

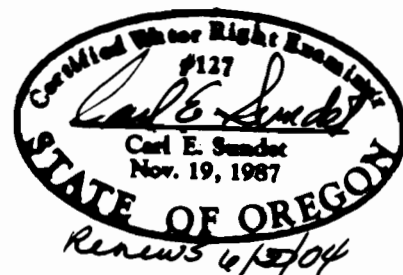

This map is for the purpose of identifying the location of the water right only and is not intended to provide legal dimensions or location of property ownership lines.