


T. 17S., R. 19E., W. M.

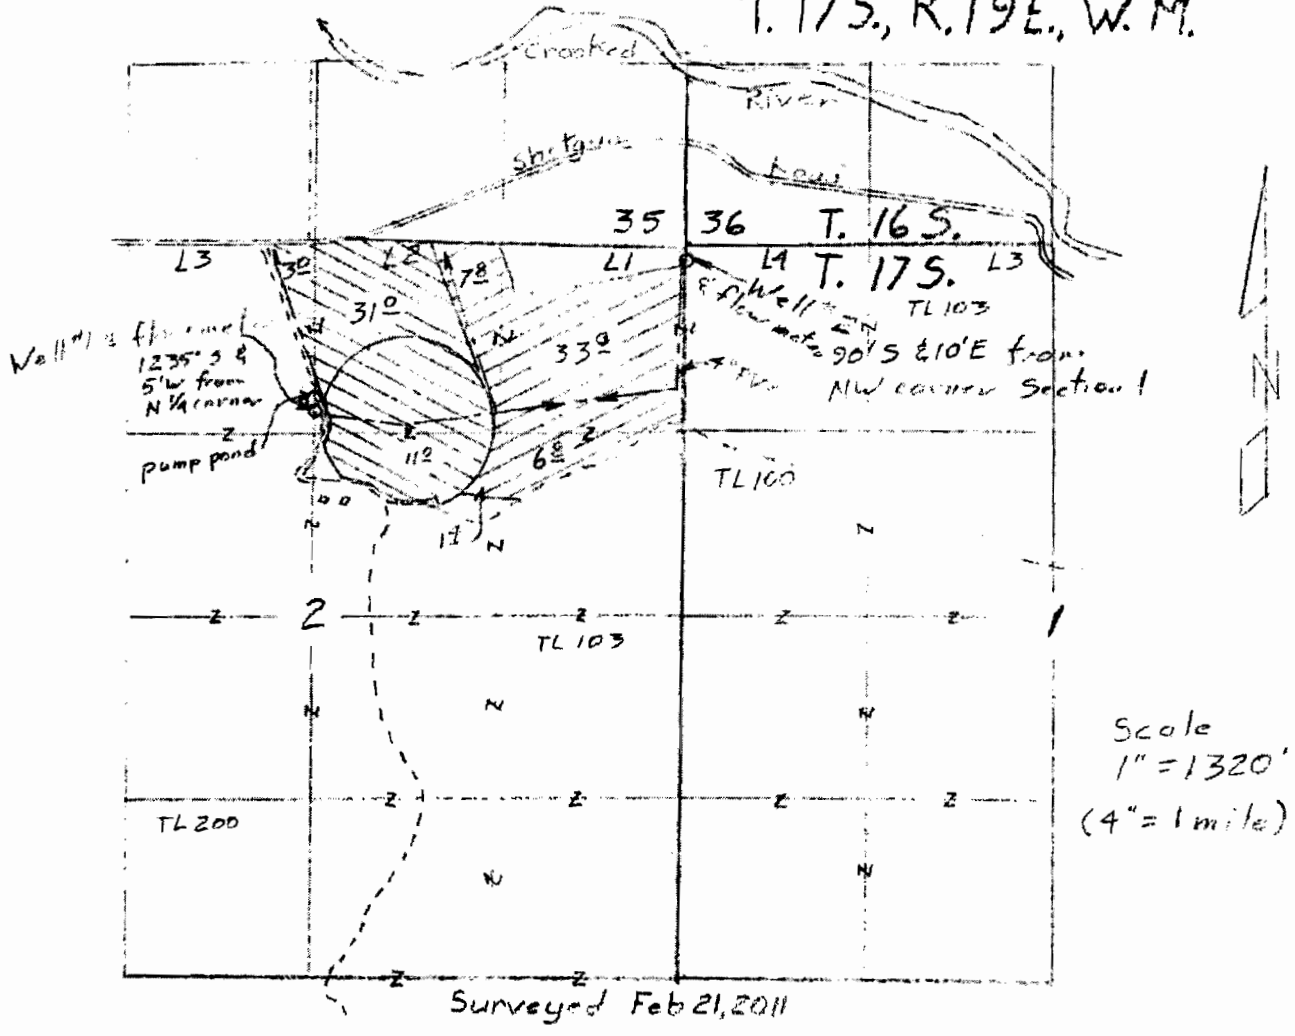


- ⊗ G-13781 Well #1 45[±] acres
- ⊗ G-15567 Well #2 49[±] acres

Claim of Beneficial Use Map
for
Shotgun Ranch, LLC
App G-14955, Permit G-13781



T. 17 S., R. 19 E., W. M.

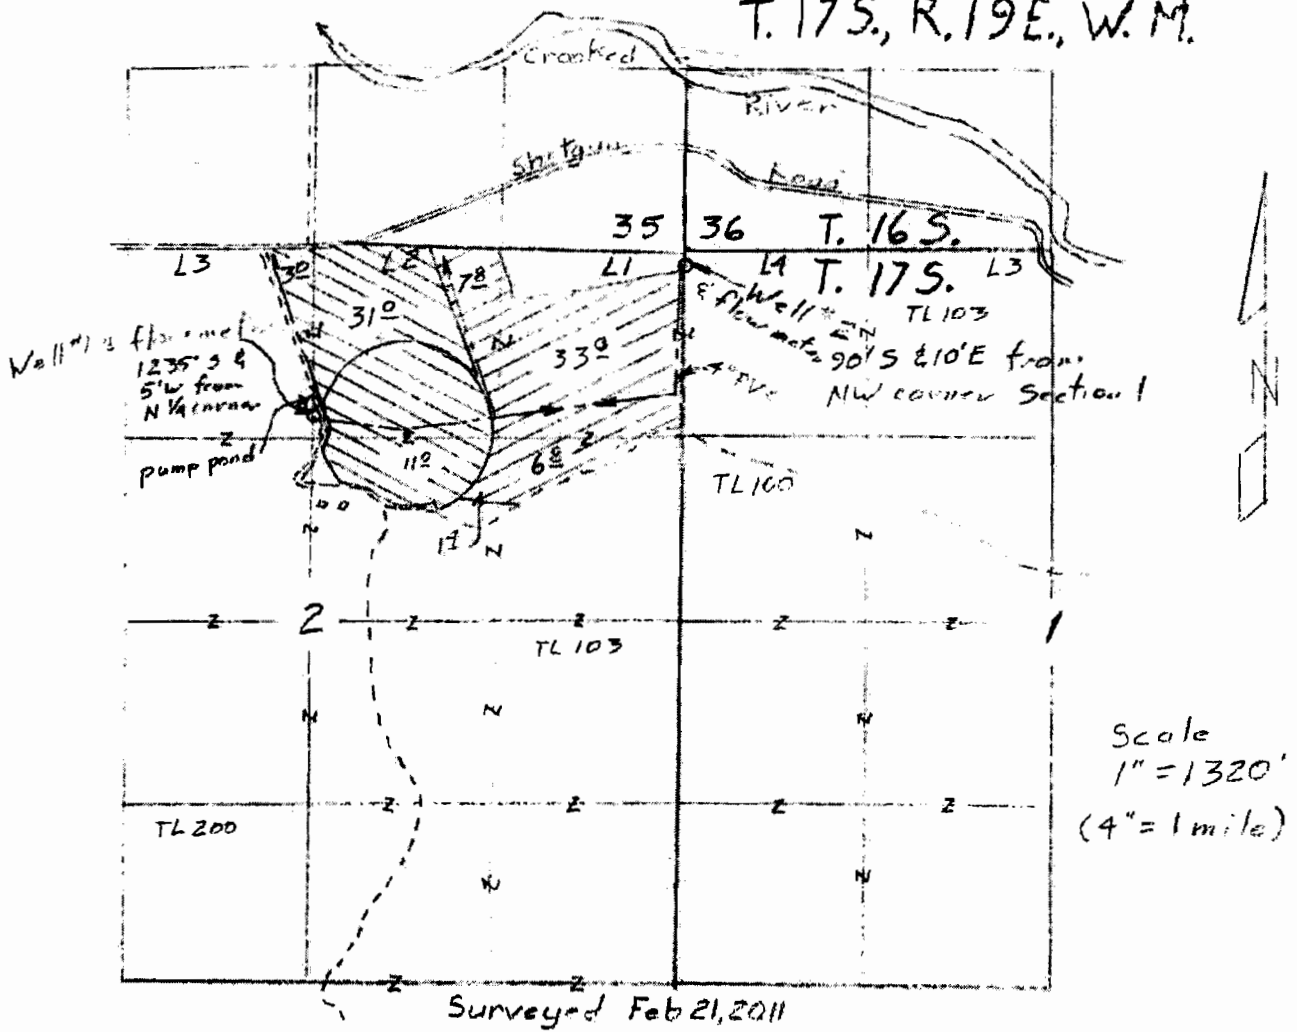

Scale
1" = 1320'
(4" = 1 mile)

- ⊗ G-13781 Well #1 45[±] acres
- ⊗ G-15567 Well #2 49[±] acres

Claim of Beneficial Use Map
for
Shotgun Ranch, LLC

App G-14955, Permit G-13781

