0301

FINAL PROOF MAP
FOR TRANSFER T-9620
STANFIELD HUTTERIAN FARM
PERMIT 37121, AND PERMIT 37833
T4N, R30E WM

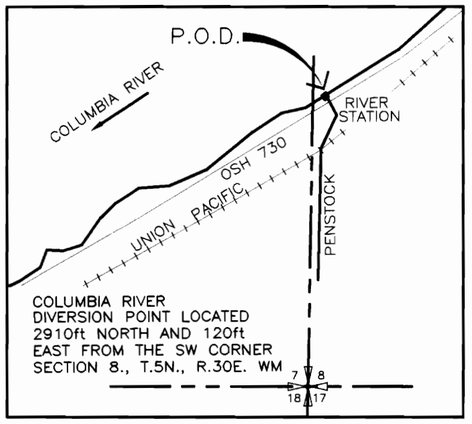

R. 29E. / R. 30E.

0 1320 2640

SCALE IN FEET

LEGEND

SECTION WHERE CIRCLE IS LOCATED

CIRCLE NUMBER

BOOSTER

CLUSTER NUMBER

T. 5N.

T. 4N.

BOOSTER NO. 1 4400 HP

PENSTOCK 24,000'-48"ø

BOOSTER NO. 2 1250HP

BOOSTER NO. 3 350 HP

BOOSTER NO. 4 80 HP

TL 702 TL 500 TL 402 TL 704 TL 705 TL 900 TL 801 TL 703 TL 1000

NOTE:
THIS MAP IS FOR THE PURPOSE OF IDENTIFYING THE LOCATION OF THE CENTER PIVOTS ONLY AND IS NOT INTENDED TO PROVIDE LEGAL DIMENSIONS OR LOCATION OF PROPERTY OWNERSHIP LINES. INFORMATION ON THIS MAP HAS BEEN PREPARED USING EXISTING MAPS AND OTHER INFORMATION MADE AVAILABLE BY THE OWNERS AND INFORMATION OBTAINED IN THE FIELD WHERE AVAILABLE.

Certified Water Right Examiner #335 WRE
Dale R. VanSchoonhoven
May 19 1992
9/26/07
State of Oregon

COBU MAP #0301

9/25/07

DRAWING: H:\CAD\AG\3522\178\352217807FP.dwg
PRINTED BY: Roger.Willard on 09/25/07 08:52 AM