


T.4N. R.25E. W.M.

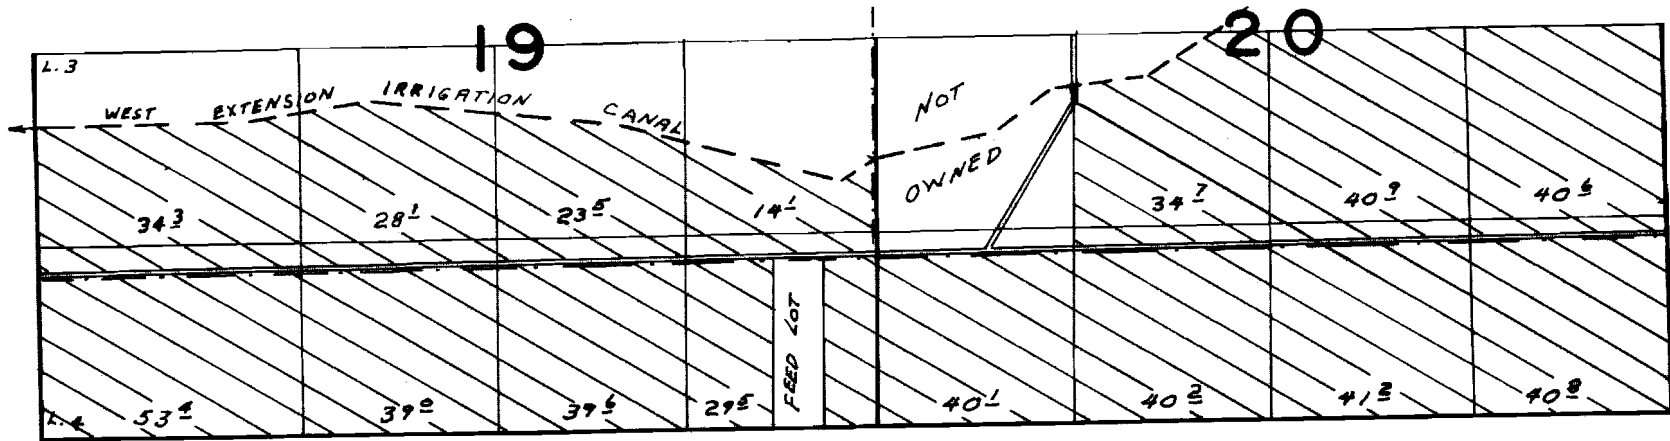


FINAL PROOF SURVEY UNDER

APPLICATION NO. 45476 PERMIT NO. 33937
IN NAME OF

BILDCO CORP.

SURVEYED SEP 17, 1975, BY L.H. NUNN

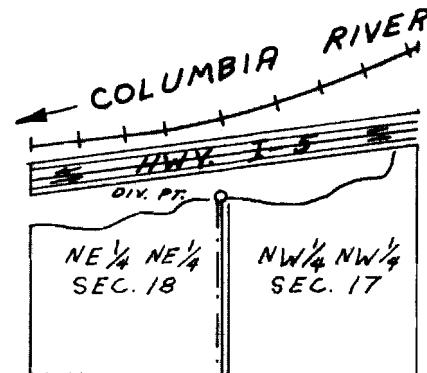

DIV. PT. LOC. 1190' N & 10' W
FROM SE COR. NE 1/4 NE 1/4, SEC. 18