


T. 31 S., R. 8 W., W.M., Section 11

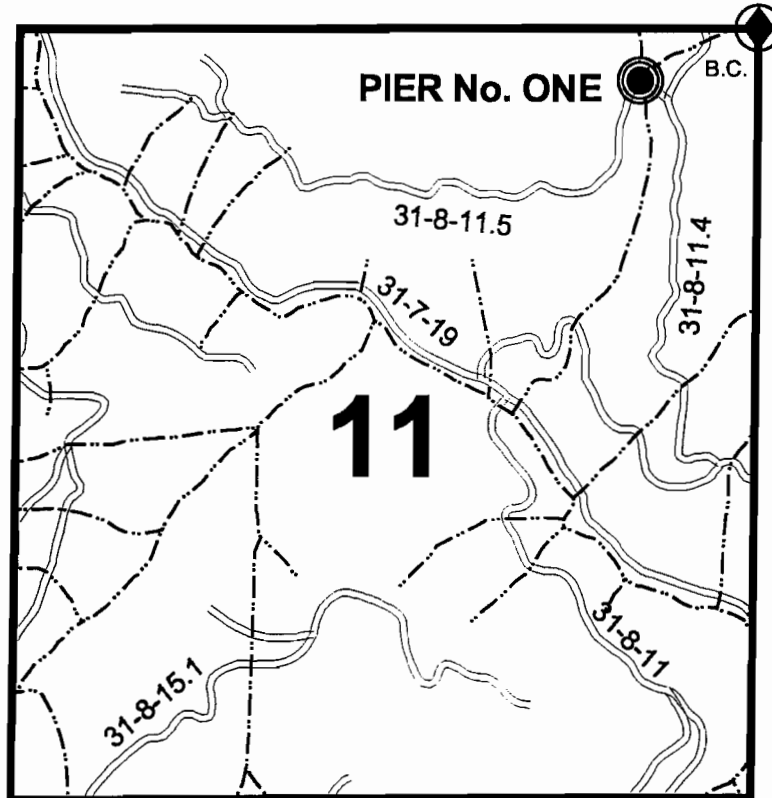

SCALE:
1" = 1320'



Diversion is:
351 ft. South and
804 ft. West of the
NE cor. Sec 11

CLAIM OF BENEFICIAL USE MAP

in name of

UNITED STATES BUREAU OF LAND MANAGEMENT

Application No.: R - 70713

S - 70521


Permit No.: R - 12032

52777

RECEIVED

SEP 25 2000

WATER RESOURCES DEPT
SALEM, OREGON

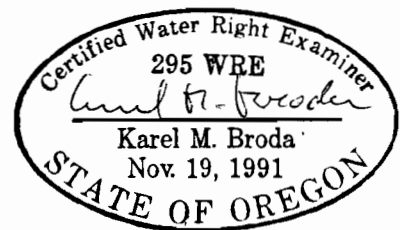

Expires: 12/31/01

SURVEYED: May 2, 2000

THIS MAP WAS PREPARED FOR THE PURPOSE OF IDENTIFYING THE LOCATION OF A WATER RIGHT ONLY
AND IS NOT INTENDED TO PROVIDE LEGAL DIMENSIONS OR LOCATION OF PROPERTY OWNERSHIP LINES.

U.S. Bureau of Land Management
Roseburg District Office
Division of Operations

Executed by:
Karel M. Broda, PE, CWRE
777 N.W. Garden Valley Blvd.
Roseburg, Oregon 97470