


T. 25 S., R. 1 W., W.M., Section 3

Diversion is:
1975 ft. South and
1036 ft. East of the
NW cor. Sec 3

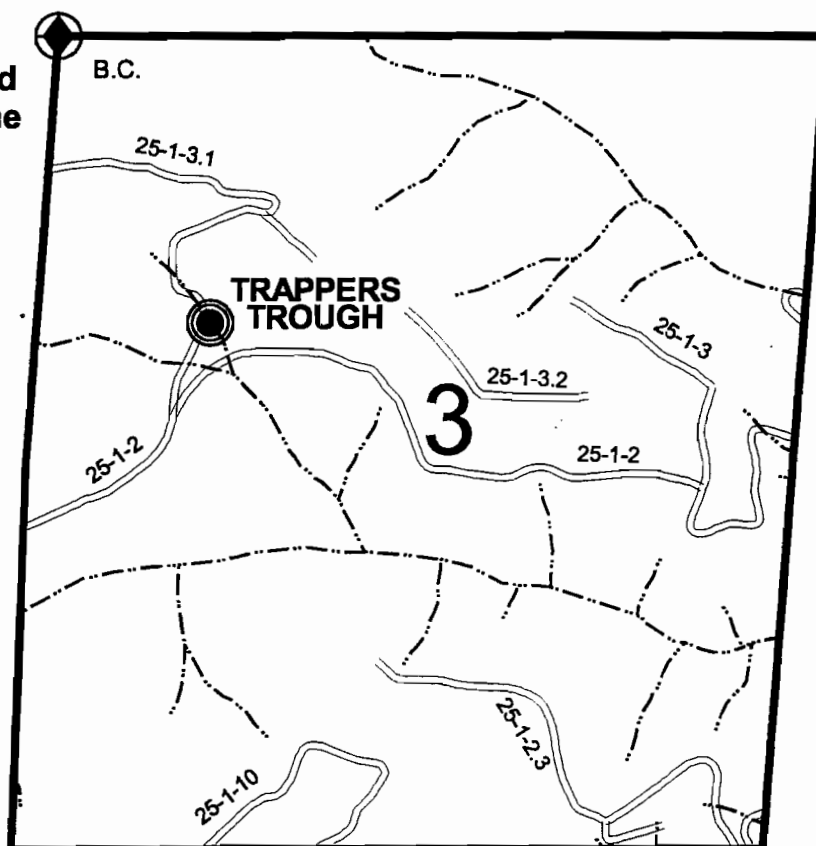

CLAIM OF BENEFICIAL USE MAP

in name of


UNITED STATES BUREAU OF LAND MANAGEMENT

Application No.: R - 71498

S - 71497

Permit No.: R - 11799

52286

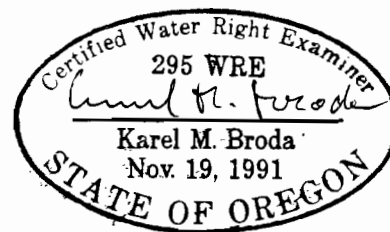

Expires: 12/31/01

SURVEYED: May 18, 2000

THIS MAP WAS PREPARED FOR THE PURPOSE OF IDENTIFYING THE LOCATION OF A WATER RIGHT ONLY
AND IS NOT INTENDED TO PROVIDE LEGAL DIMENSIONS OR LOCATION OF PROPERTY OWNERSHIP LINES.

U.S. Bureau of Land Management
Roseburg District Office
Division of Operations

Executed by:
Karel M. Broda, PE, CWRE
777 N.W. Garden Valley Blvd.
Roseburg, Oregon 97470