


# T. 39 S., R. 5 W., W. M.

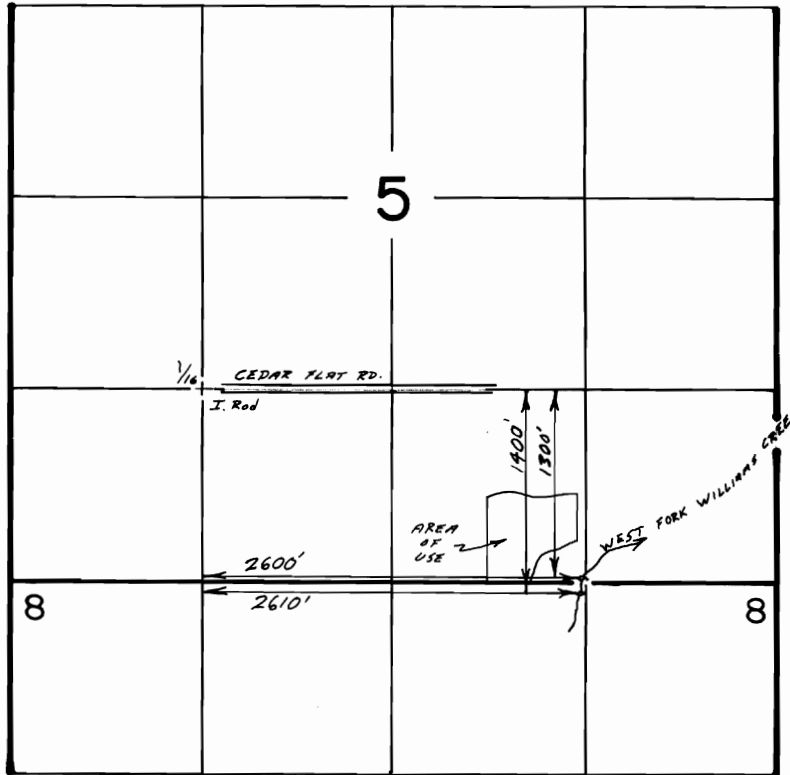

Scale 1"=1320'

## FINAL PROOF SURVEY

UNDER

Transfer No. 3724

Application No. .... Permit No. ....

IN NAME OF

.....DON T. DURBORAN Jr.....

Surveyed July 13, 1988, by B.S. JAMES.....