


T.39S.,R.1E.,W.M.

RECEIVED

APR 27 1998

WATER RIGHTS DEPT
Salem, Oregon

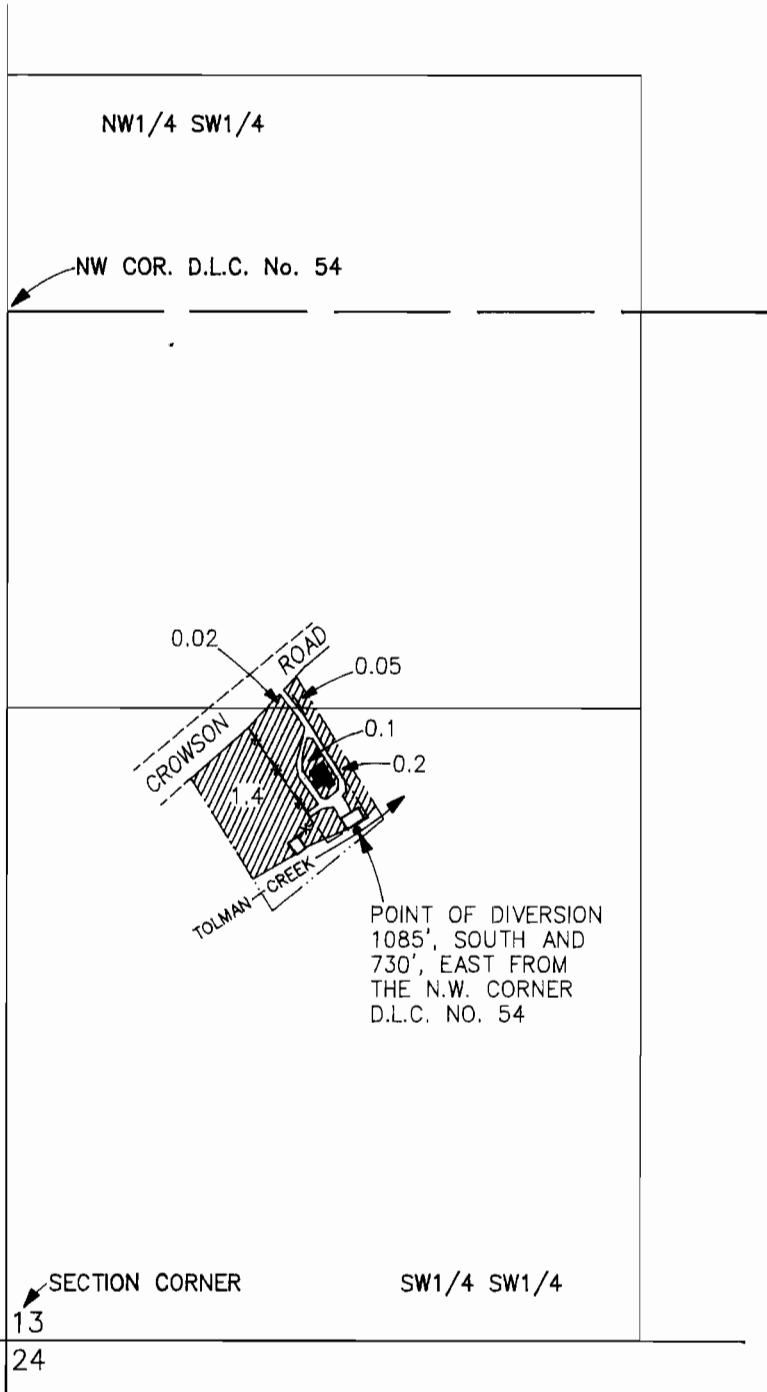

SCALE 1" = 400'

NOTE: MAP PREPARED FOR
WATER RIGHT PURPOSES ONLY,
NOT FOR PROPERTY BOUNDARY
LOCATIONS.

FINAL PROOF MAP

APPLICATION No. T-7733

IN THE NAME OF
DARREL L. WILTROUT

MAP PREPARED APRIL 6, 1998
BY GARY D. KAISER

