

RECEIVED


MAR 12 2012

WATER RESOURCES DEPT  
SALEM, OREGON

Claim of Beneficial Use Map  
for  
Shotgun Ranch, LLC

T-9908


T.17S., R.20E., W.M.

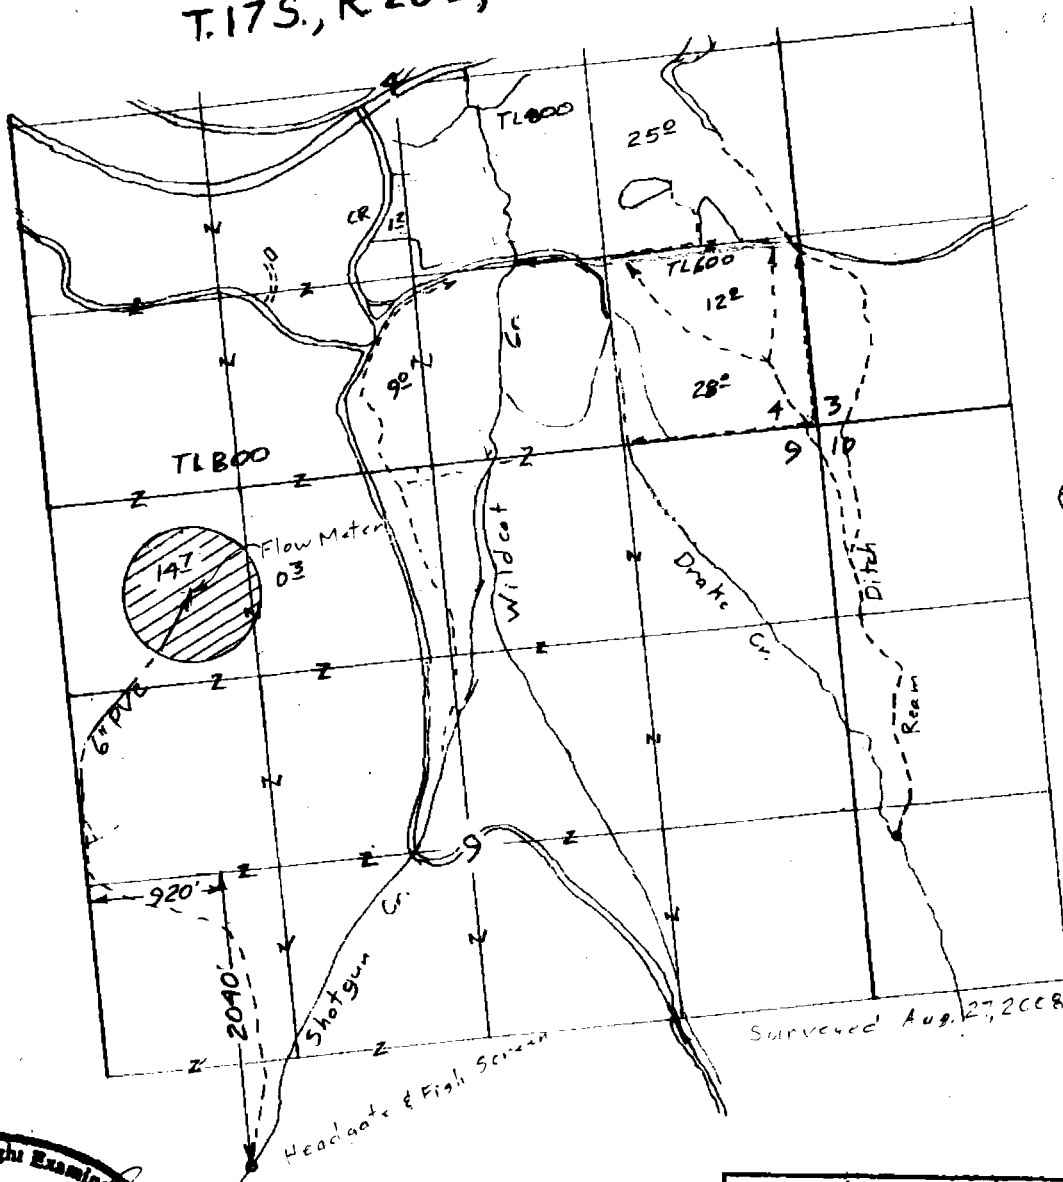

Scale 1"=1320'

⊗ To 15<sup>±</sup> acres

Surveyed Aug. 27, 2008

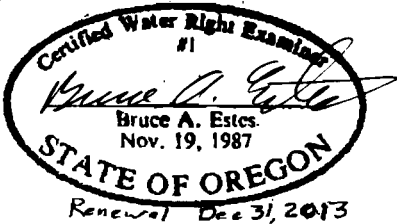

This map is for the purpose of locating a water right only and has no intent to provide legal dimensions or the location of property lines.

**ESTES SURVEYS, LLC**

PO Box 17519  
Salem, OR 97306-7519  
(503) 500-7500

60382 Arnold Rd  
Bend, OR 97702  
(541) 382-7391