


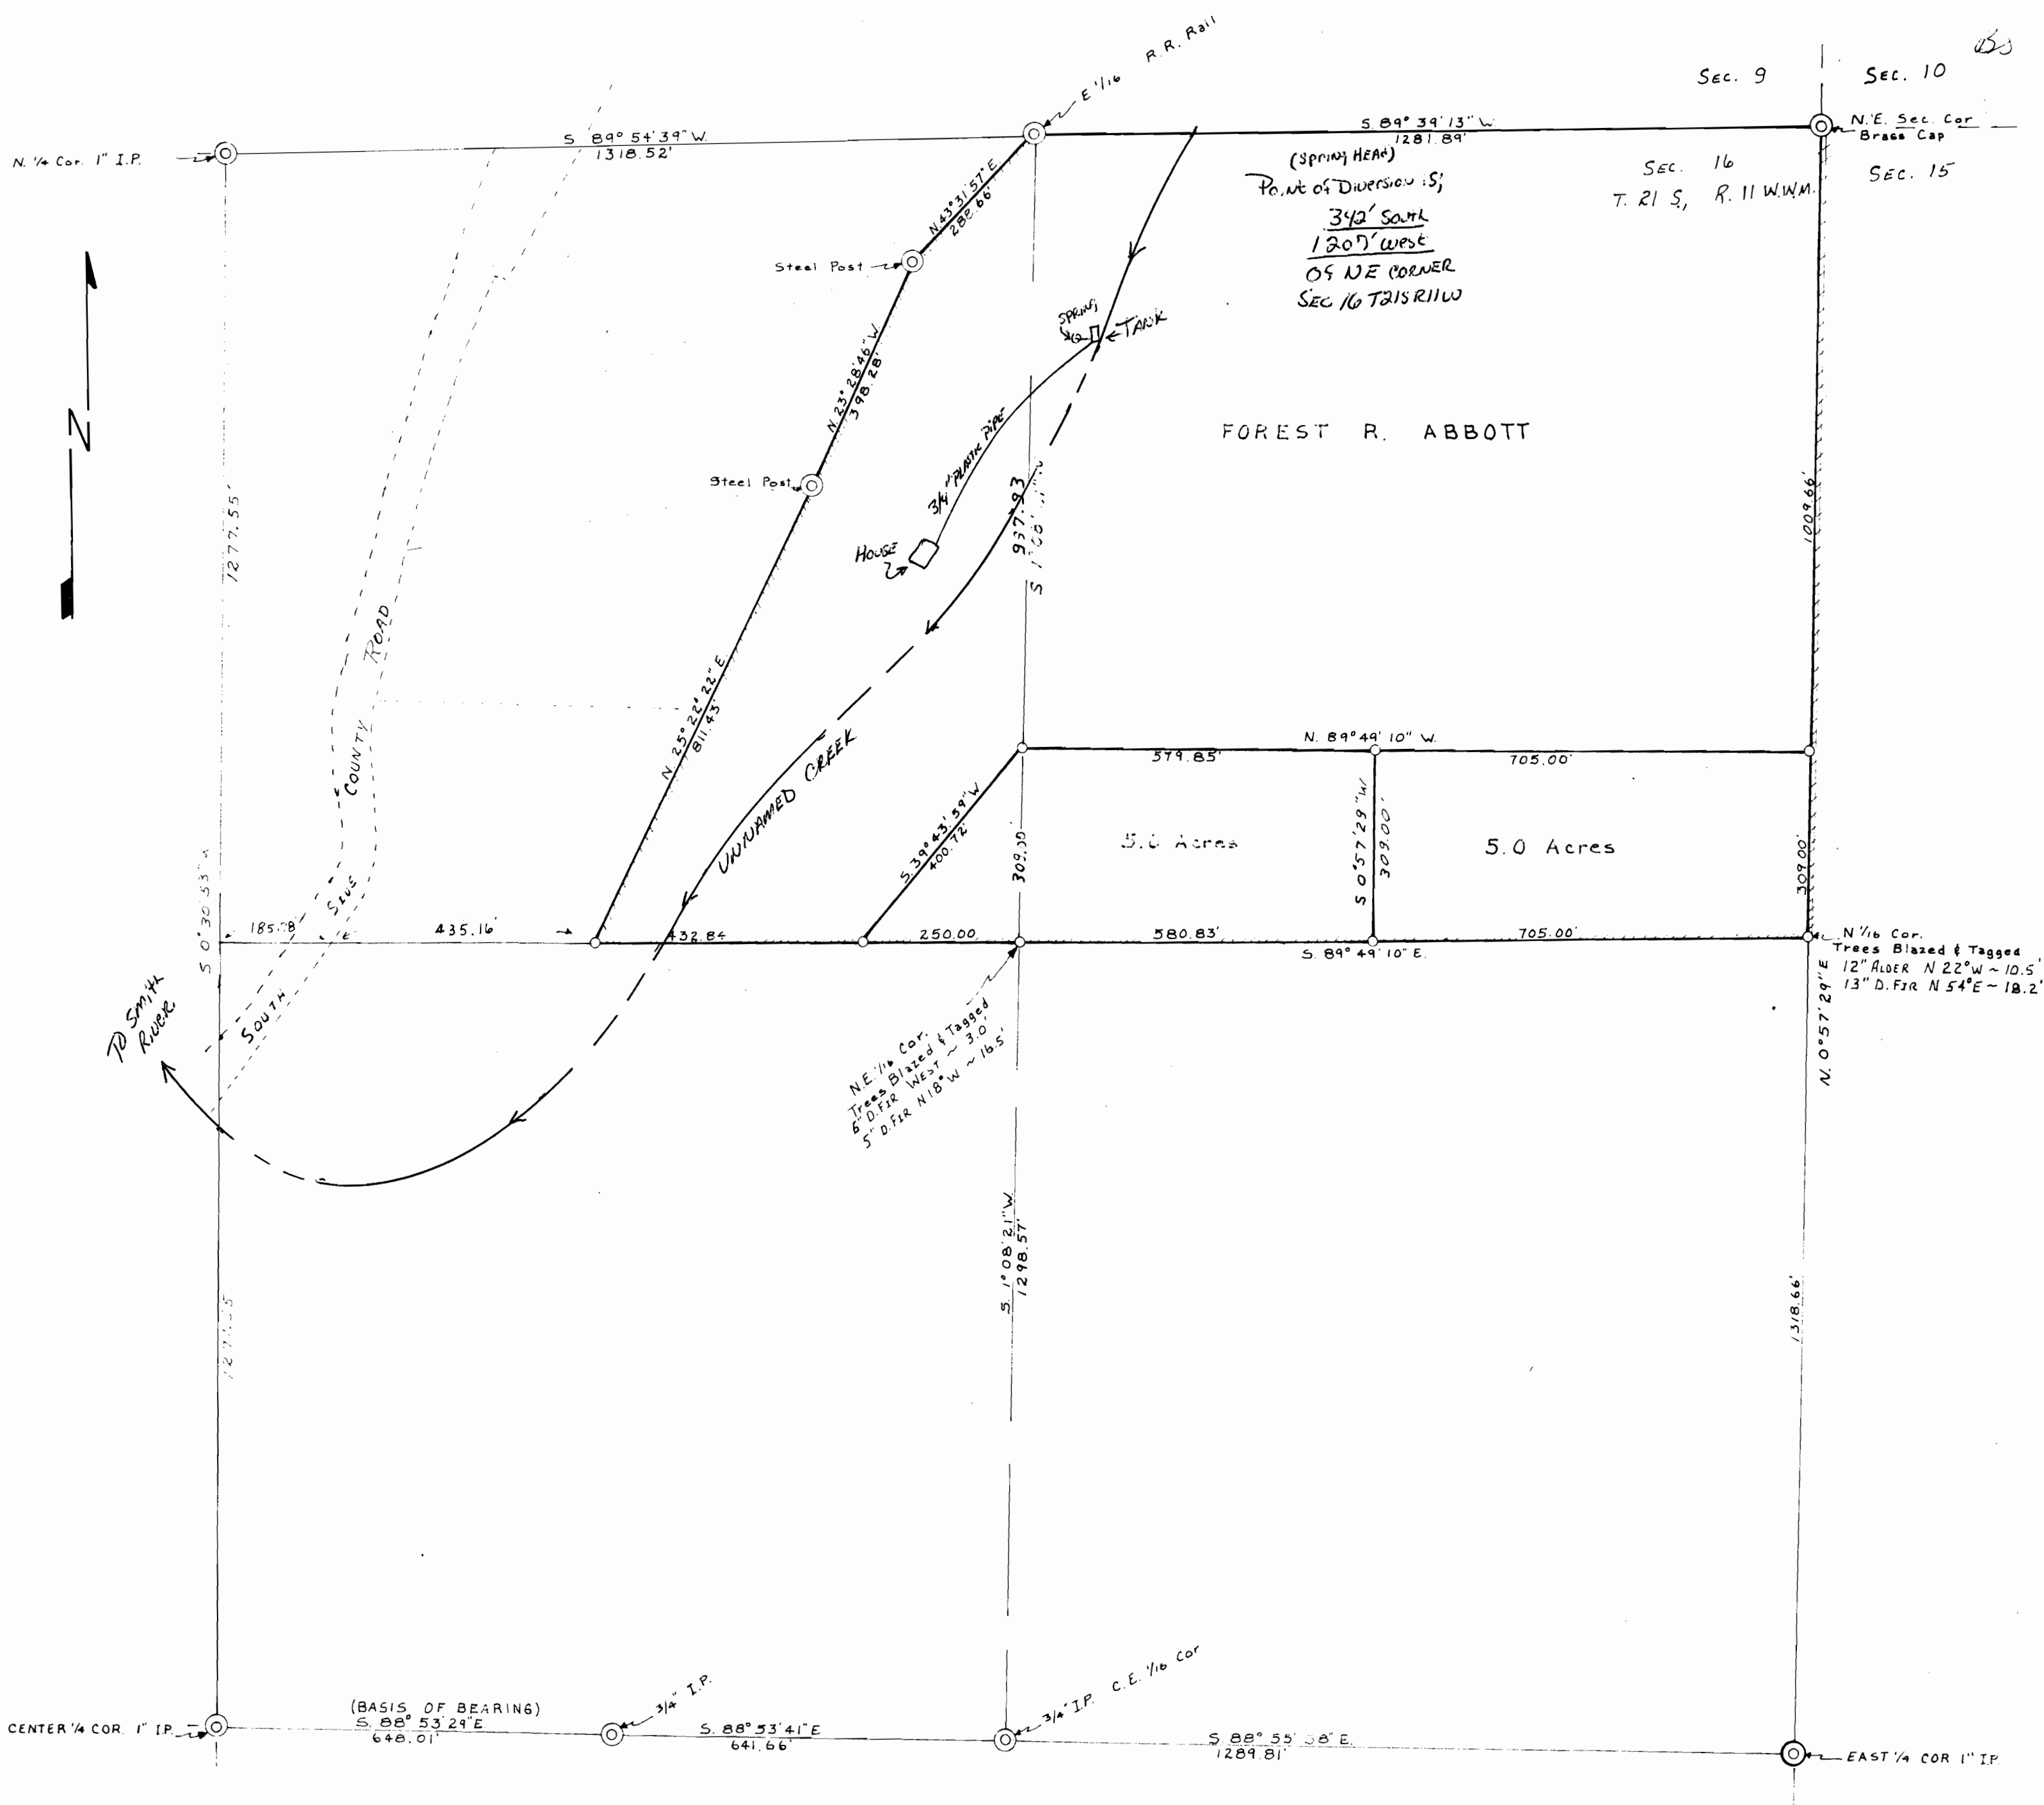

RECEIVED
MAY 01 1986
WATER RESOURCES DEPT
SALE, OREGON