


T. 1 S., R. 3 W., W.M.

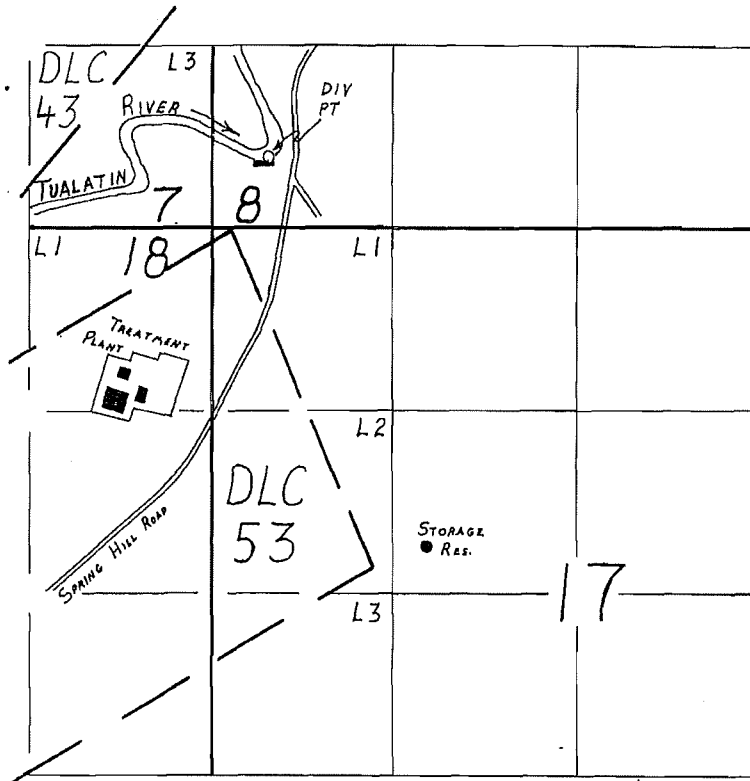

DIV. PT. LOCATION: 500' NORTH and 410' EAST
FROM THE SOUTHWEST CORNER,
SECTION 8.

FINAL PROOF SURVEY

UNDER

Transfer Number 3130
IN NAME OF

CITY OF HILLSBORO

Surveyed AUGUST 8, 1986, by B.W. BISHOP

RECEIVED

APR 25 2012

WATER RESOURCES DEPT
SALEM, OREGON