

RECEIVED


MAR 1 1998

WATER RESOURCES DEPT.
SALEM, OREGON

FINAL PROOF SURVEY

FOR TRANSFER 7773
LOCATION OF NEW POINT OF APPROPRIATION
LOCATED IN SECTIONS 3 AND 10
TOWNSHIP 33 SOUTH, RANGE 18 EAST, W.M.
LAKE COUNTY, OREGON

TOWNSHIP 33 SOUTH

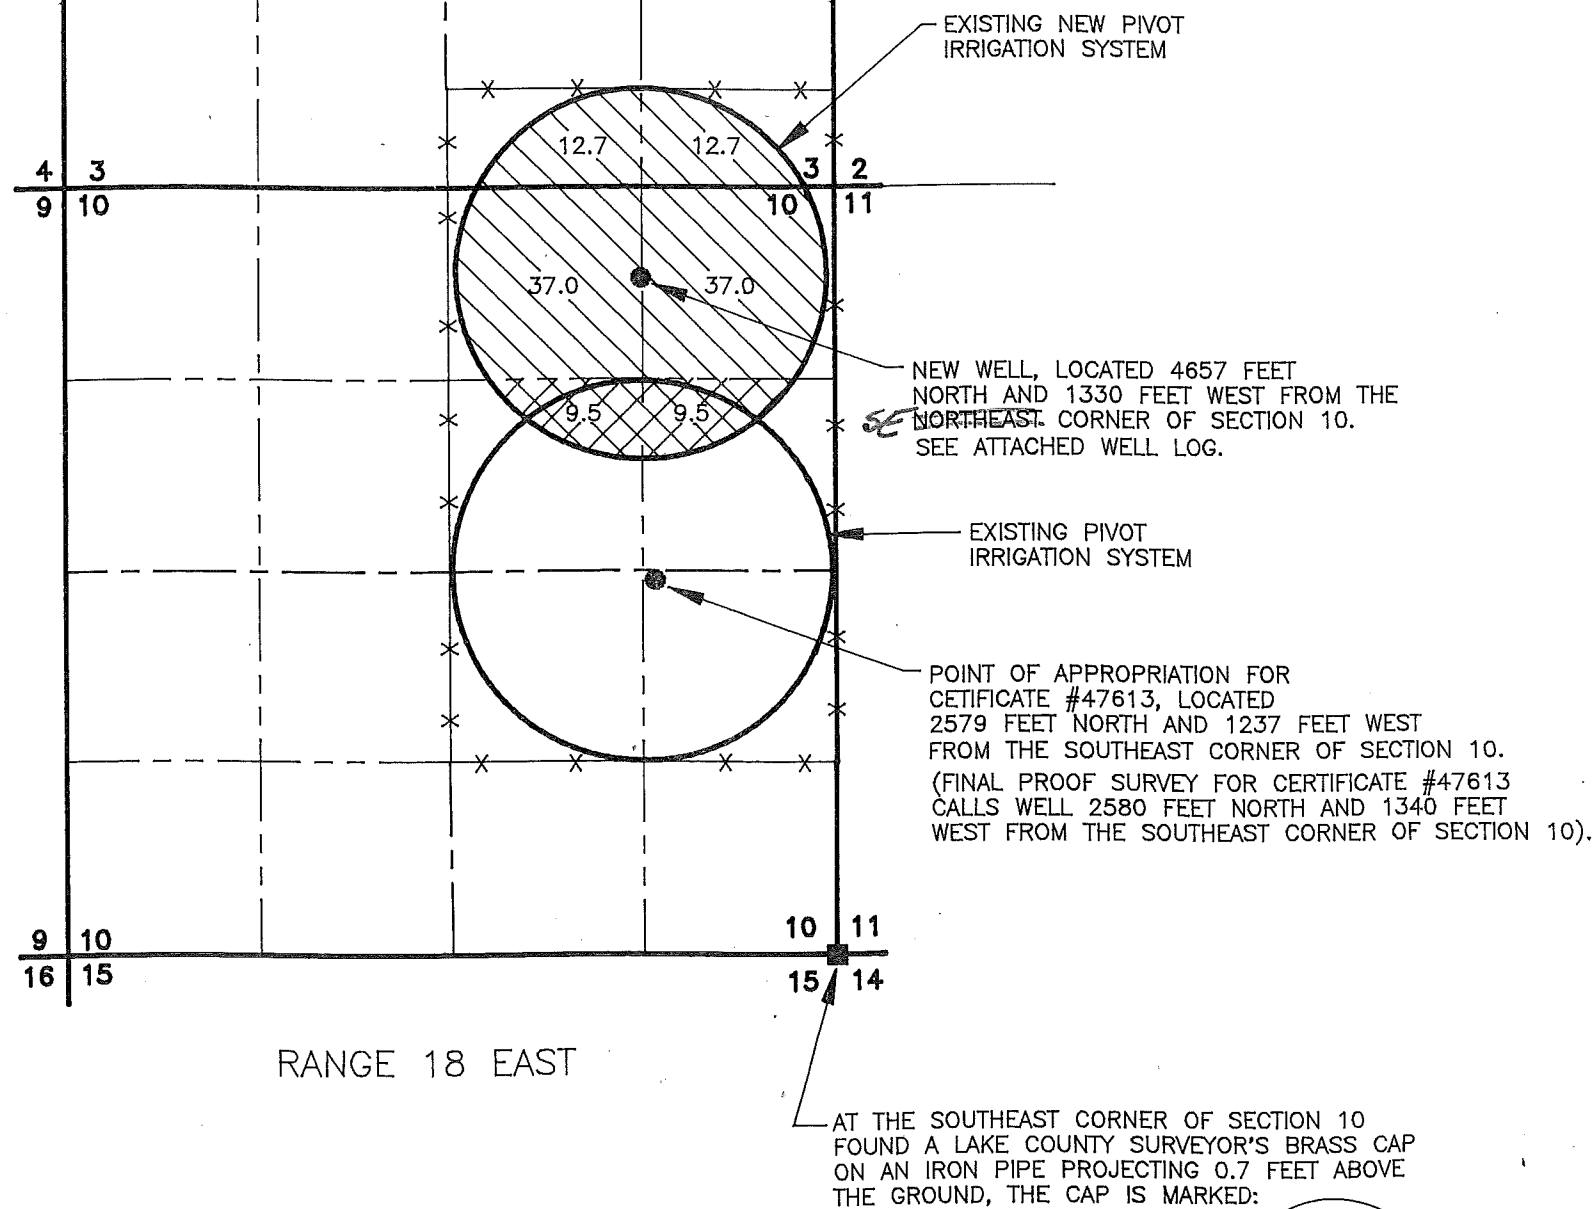


LEGEND

- SECTION LINE
- 1/4 SECTION LINE
- 1/16 SECTION LINE
- EXISTING WELL
- FOUND LAND SURVEY MONUMENT AS NOTED.
- EXISTING BARB WIRE FENCE
- 99.4 ACRES UNDER CERTIFICATE #65919 TO BE IRRIGATED FROM NEW WELL AS PER TRANSFER T-7773.
- 19.0 ACRES BEING IRRIGATED FROM NEW WELL AS SHOWN, AREA TO BE SUPPLEMENTAL TO WATER RIGHTS UNDER CERTIFICATE #47613.

TOTAL ACRES IRRIGATED UNDER NEW WELL AS PER T-7773= 118.4 ACRES

NOTE: PREPARATION OF THIS MAP IS FOR IDENTIFYING PROPOSED WATER RIGHTS ONLY. IT HAS NO INTENT TO PROVIDE LOCATIONS OR DIMENSIONS OF PROPERTY BOUNDARIES.

SEE ACCOMPANYING
SITE REPORT

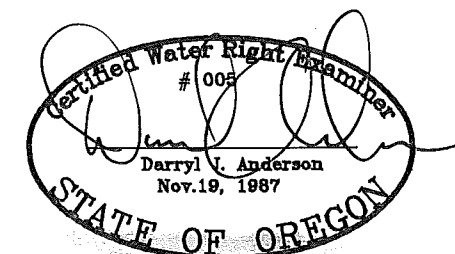

RENEWAL 12/31/99

REVISION BY

ANDERSON ENGINEERING
AND SURVEYING, INC.
P.O. BOX 28
LAKEVIEW, OREGON 97630
(541) 947-4407
FAX 947-2321

PREPARED FOR:
ALAN G. AND V. GINGER WITHERS
ROUTE 1, BOX 70
PAISLEY, OREGON 97636

DATE: 2/24/98
SCALE: 1"=1320'
JOB: 97158
DWG. BY: R.F.C.
FILE: 97158
SHEET 1 OF 1

SCALE: 1"=1320'

Map updated 9-5-2012 AC WRD