

LEGEND

- USGS GRID
- - - - - DLC BOUNDARY
- TAXLOT LINE
- ROADWAY
- STRUCTURE
- PIPING
- ⊕ SECTION CORNER
- ▭ P.O.U.

PREPARATION OF THIS MAP IS FOR THE PURPOSE OF IDENTIFYING THE LOCATION OF THE WATER RIGHT ONLY. THERE IS NO INTENT TO PROVIDE DIMENSIONS OR LOCATION OF PROPERTY OWNERSHIP LINES.

NOTES:

WELL 1 (YAMH 3865) IS LOCATED 1330 FEET SOUTH AND 1850 FEET WEST FROM THE NW CORNER OF DLC 54

T. 3S. R2W., W.M.

Claim of Beneficial Use Re-Map

YAMHILL COUNTY

Survey AND RE-MAP

UNDER

APPLICATION No. G-14040,

PERMIT No. G-13458

SURVEYED OCTOBER 12, 2012


BY JOHN E. BORDEN, CWRE

P.O.U. - PLACE OF IRRIGATION USE WATER USE ACREAGE

SECTION 18

ALL WITHIN DLC 39

NW ¼ SW ¼ - 0.94 AC
 SW ¼ SW ¼ - 3.59 AC
 NE ¼ SW ¼ - 3.63 AC
 SE ¼ SW ¼ - 8.34 AC
TOTAL = 16.50 AC

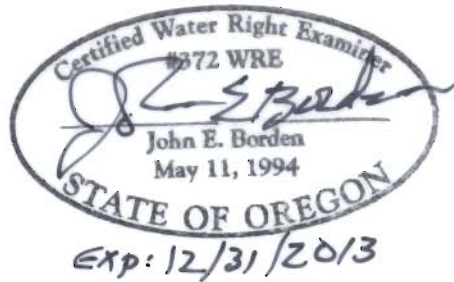

DLC 39

NWSW

NESW

NW COR
DLC 54

DLC 53


POINT OF BEGINNING OF SURVEY

SCALE:
1" = 400'

RECEIVED
DEC 06 2012

WATER RESOURCES DEPT
SALEM, OREGON

DLC 54

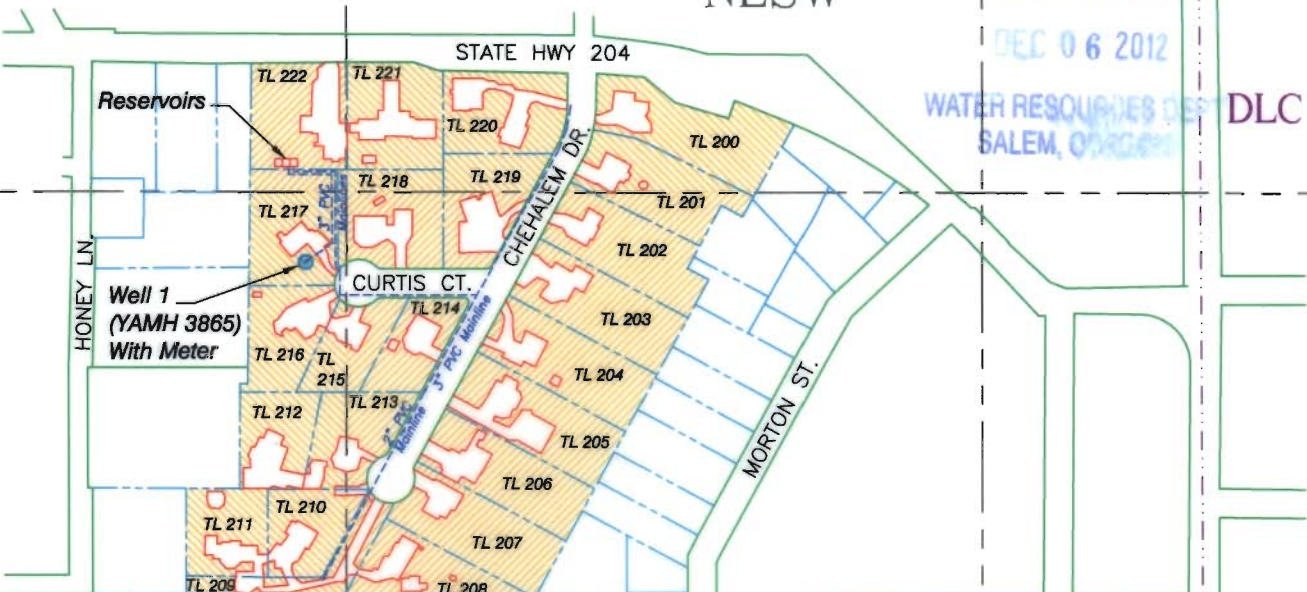

SWSW

SESW

SECTION 18
SECTION 19

S 1/4 COR
SEC 18

JOHN BORDEN CONSULTING

5597 RIVER STREET
WEST LINN, OR. 97068
503-723-4257

Aspen Estates COBU Re-Map

PATH: J4:\IM-Olson\Dillon\CAD DWGS-Revised\Aspen Estates COBU_113012.DWG