


7077  
8786

Sec. A  
Tp. 40 S  
R. 18 E  
W. 1/4

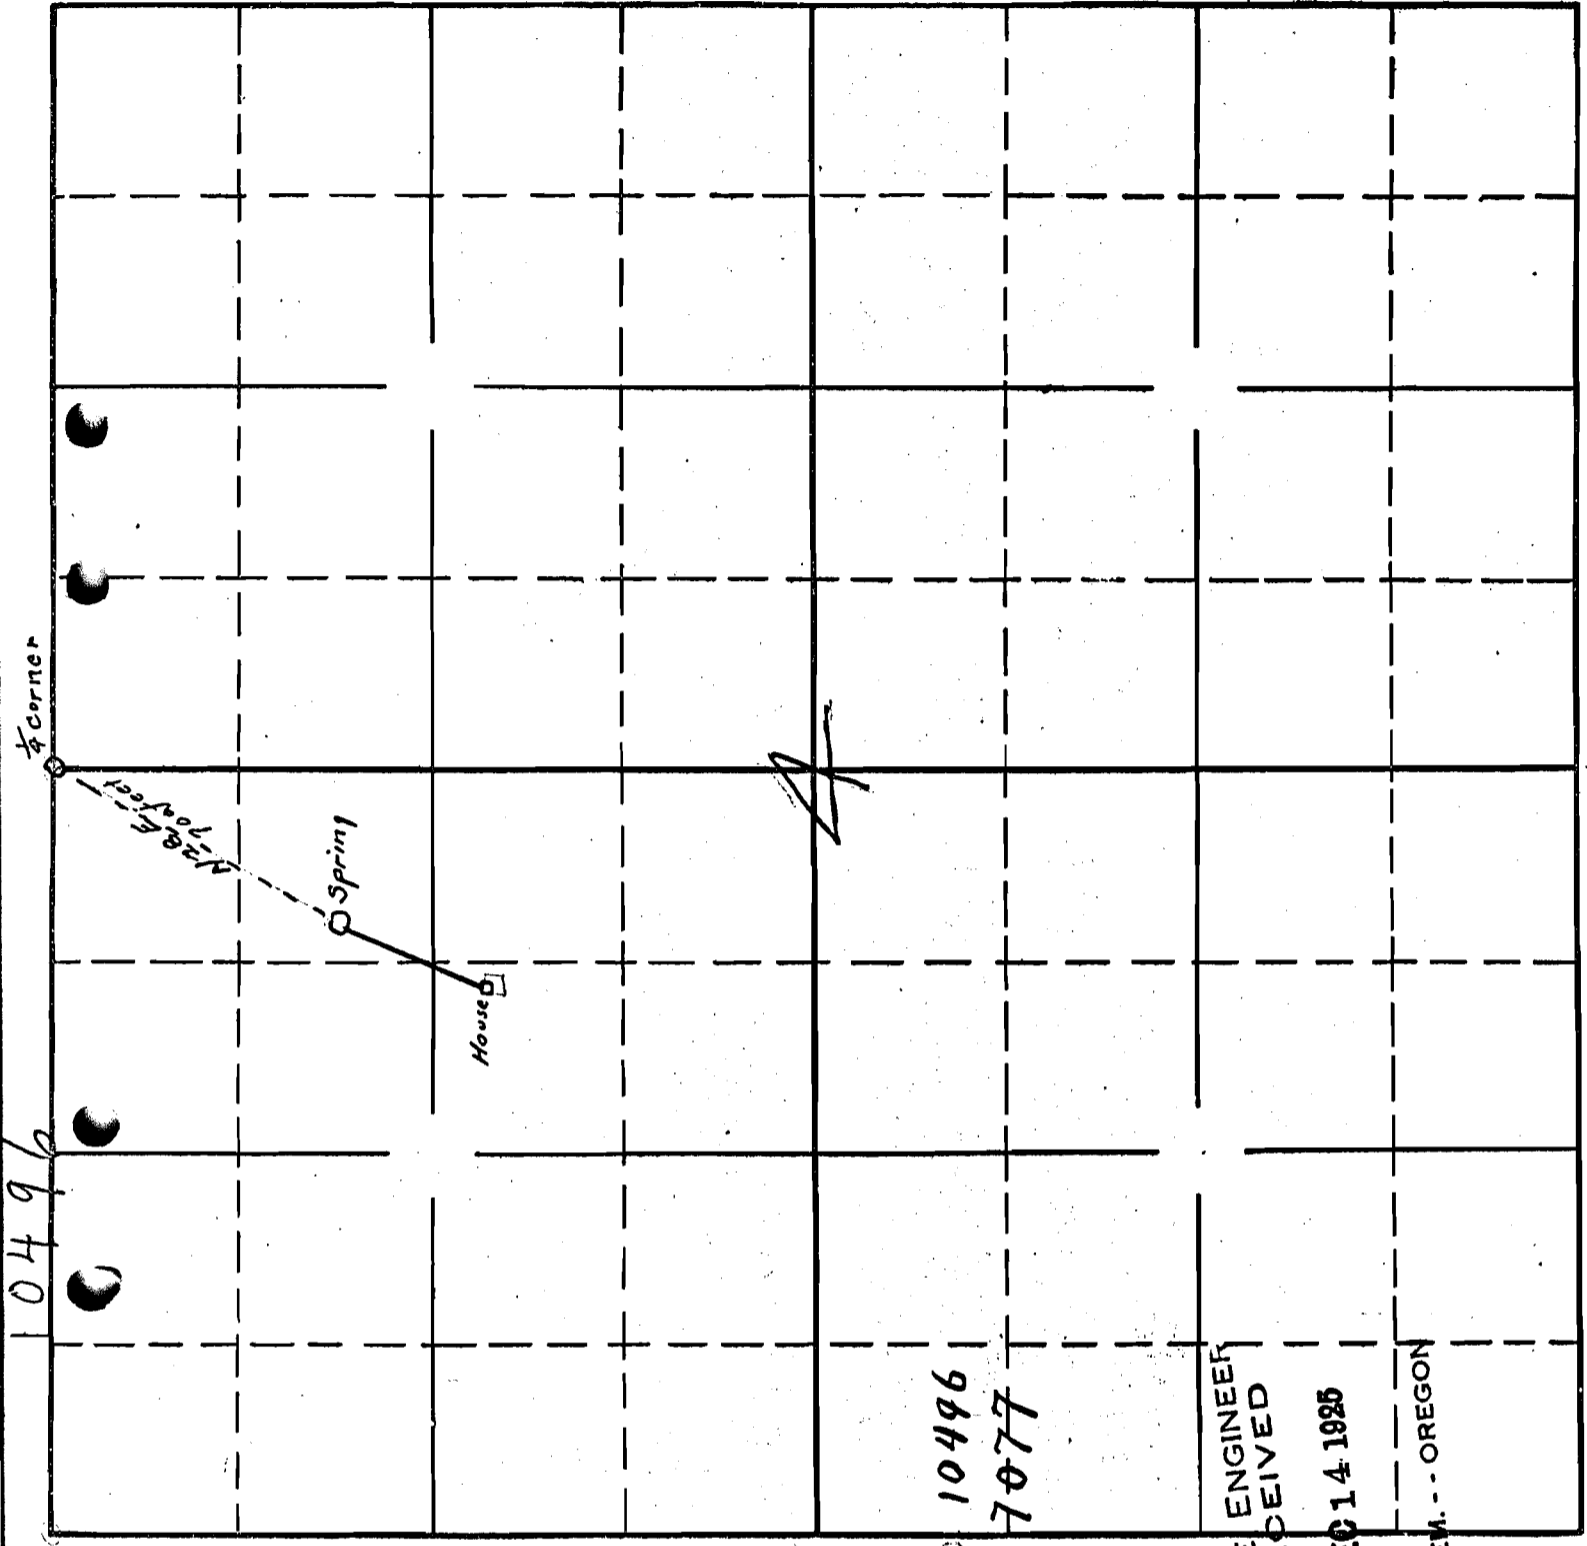

0496

Application No. 10496  
Permit No. 7077

STATE ENGINEER  
RECEIVED  
DEC 14 1925  
SALEM. - - OREGON