


T. 36 S., R. 5 W., W.M.

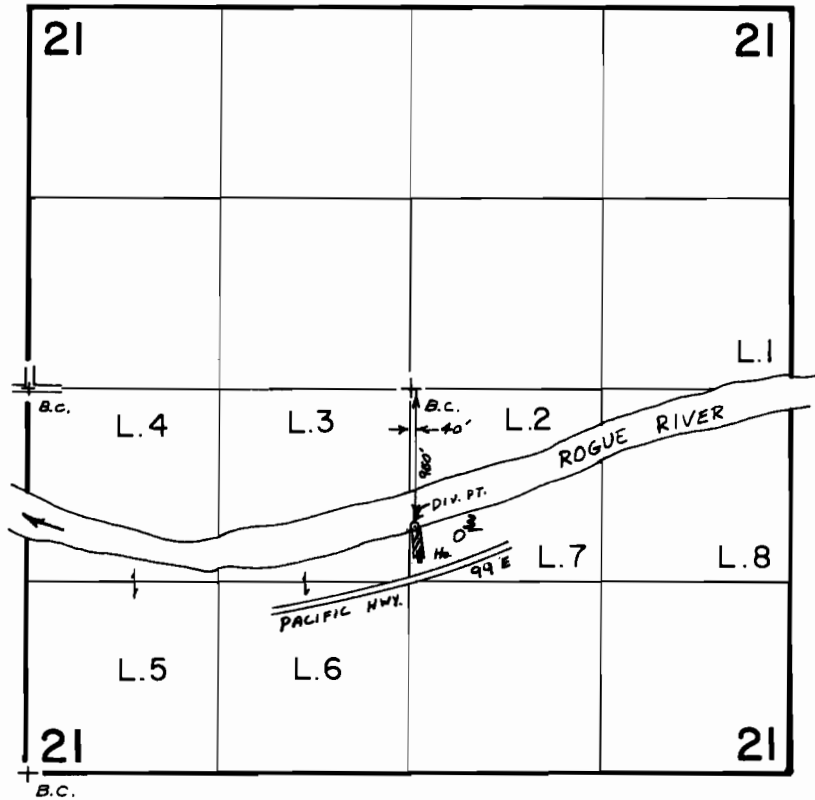

Scale: 4" = 1 mile

FINAL PROOF SURVEY
UNDER

Application No. 58260... Permit No. 43889.....
IN NAME OF

MERRILL L. & SARAH H. POLLARD

Surveyed Nov. 13, 1981, by BRUCE R. SUND