


T.5S., R.5.W, W.M

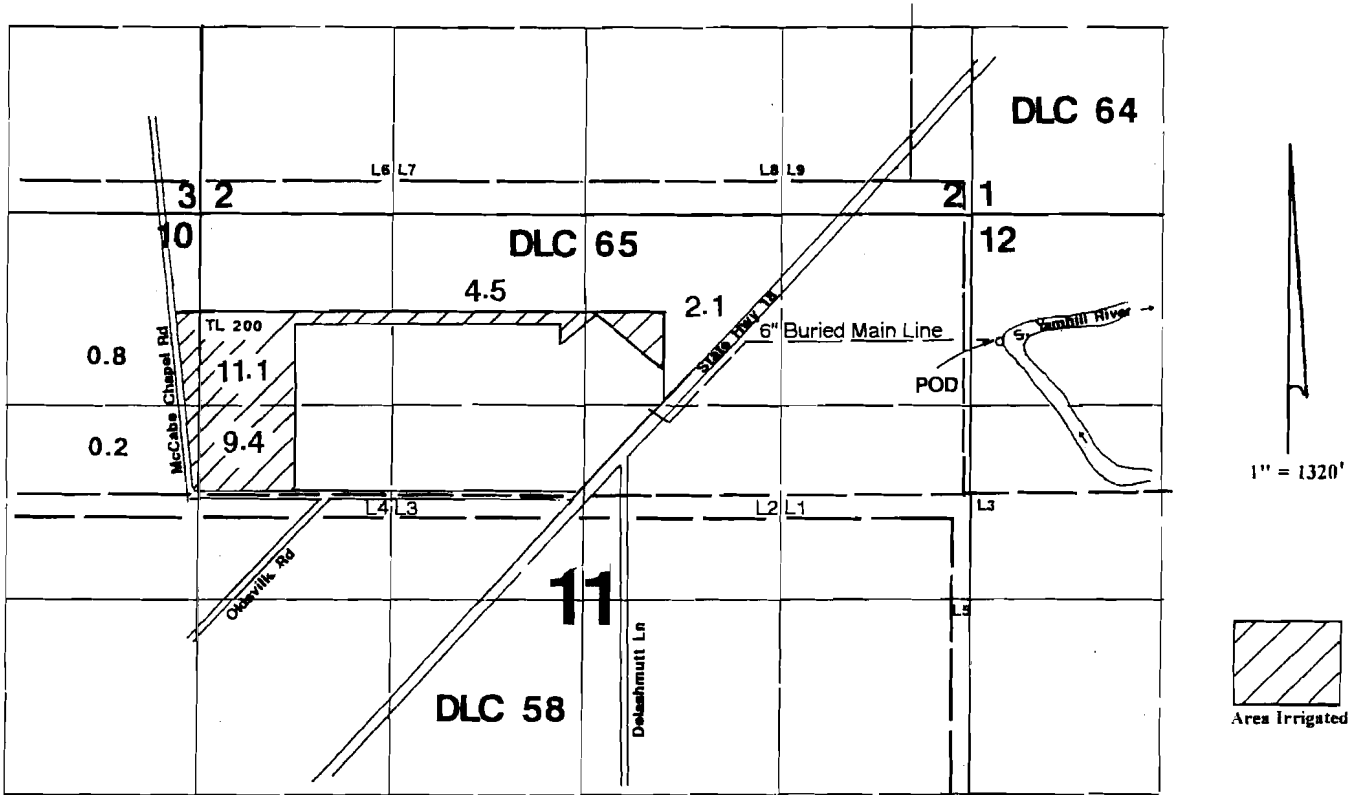

Pt. of Diversion is located 850'S & 180'E from the NW corner of Section 12.


Final Proof Survey

In Name Of

John G. Bernards

Application #: 69760 Permit #: 51712

Surveyed on November 1, 2002 by JM Schuette

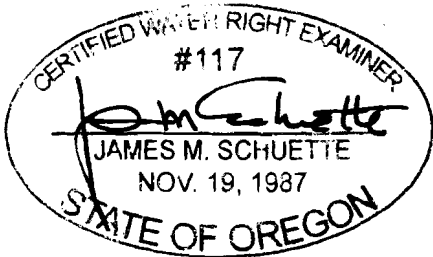

E.4-1RES: 6/30/2014

This Map Was Prepared For The Purpose Of Identifying The Location Of A Water Right Only And Is Not Intended To Provide Legal Dimensions Or Location Of Property Ownership Lines.