



T.16S.,R.4W.,W.M.

THE PURPOSE OF THIS MAP IS TO IDENTIFY THE LOCATION OF THE WATER RIGHT. IT IS NOT INTENDED TO PROVIDE LEGAL DIMENSIONS OR LOCATIONS OF PROPERTY OWNERSHIP LINES

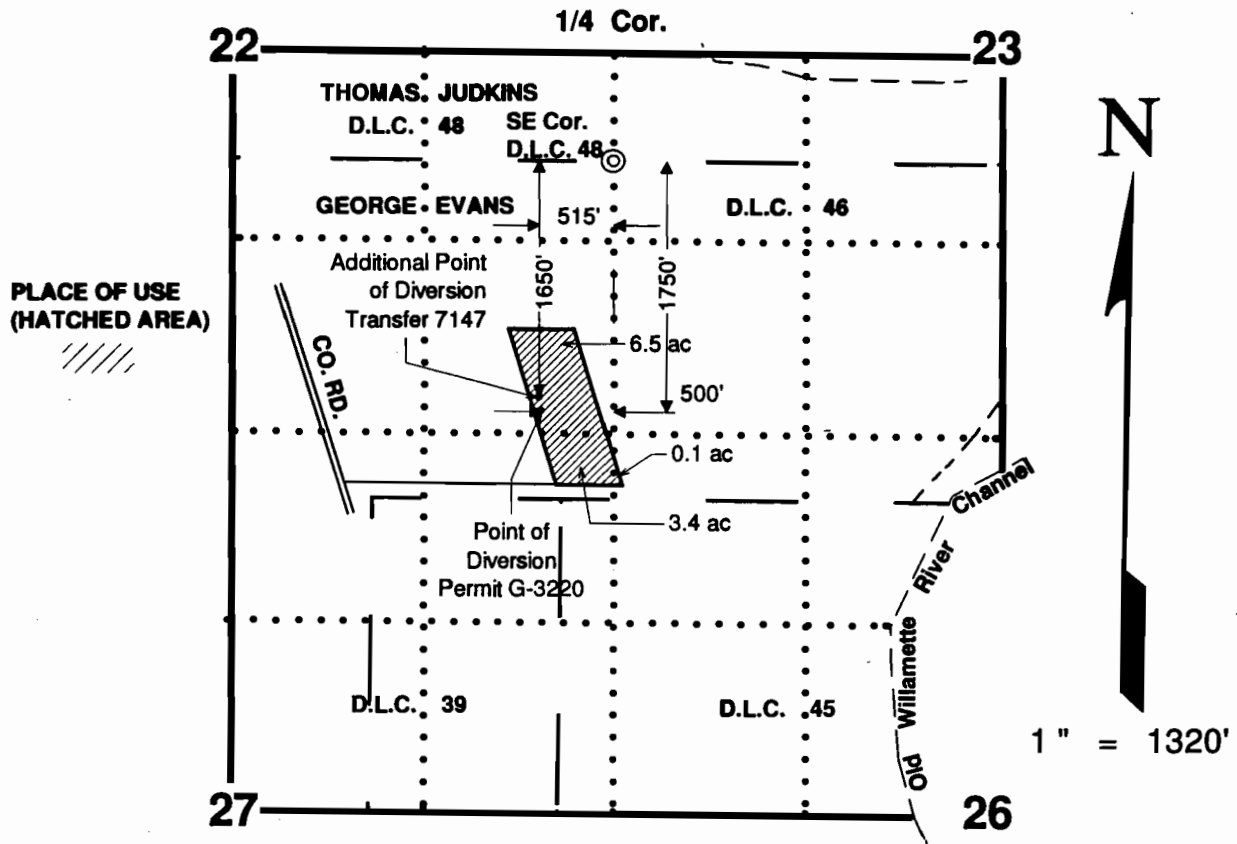

CLAIM OF BENEFICIAL USE MAP

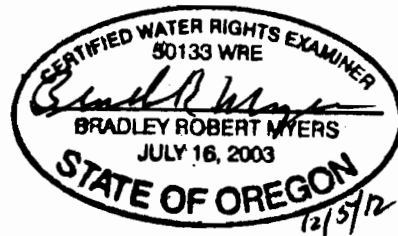

UNDER

RENEWAL DATE: DEC. 31, 2013

Application No. G-3435 Permit No. G-3220 Transfer No. 7147

IN THE NAME OF

LONE PINE FARMS, LTD

Received by OWRD
Dec 12, 2012
Salem, OR