


TOWNSHIP 1 SOUTH, RANGE 3 EAST, W.M.



FINAL PROOF SURVEY

UNDER

APPLICATION NO. R-71638, PERMIT NO. R-11469
DATE OF FIELD OBSERVATION: AUGUST 28, 1996

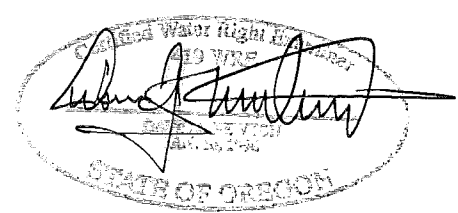

NOTE:
THIS MAP WAS PREPARED FOR THE PURPOSE OF IDENTIFYING THE LOCATION OF WATER RIGHT ONLY AND IS NOT INTENDED TO PROVIDE LEGAL DIMENSIONS OR LOCATIONS OF PROPERTY OWNERSHIP LINES.

- LEGEND**
- PERSIMMON COUNTRY CLUB PROPERTY LINE
 - EXISTING WATERWAY FEATURES
 - EXISTING SIXTEENTH LINES
 - IDENTIFICATION OF THE SIXTEENTH OF SECTION
 - RESERVOIR CONSTRUCTED OR IMPROVED UNDER PERMIT NO. R11469
 - EXISTING DAM (EMBANKMENT) CONSTRUCTED OR IMPROVED UNDER PERMIT NO. R11469
 - EXISTING WELL LOCATION

NO.	DATE	BY	REVISIONS

DAVID J. NEWTON ASSOCIATES, INC.
CIVIL & GEOLOGICAL ENGINEERING SERVICES
1201 S.W. 12TH AVENUE, SUITE 400
PORTLAND, OREGON 97205
(503) 228-7718 FAX (503) 228-7781

DESIGNED BY: SB
DRAWN BY: SB
CHECKED BY: SB
DATE: SEPT 1996
SCALE: 1" = 400'

**FINAL PROOF SURVEY
TO STORE SURFACE WATER
PERSIMMON COUNTRY CLUB**

PROJECT NO: 427-103
FILE: G:\427\103\RES-H20.DWG