


NW COR SEC.3 -BRASS CAP

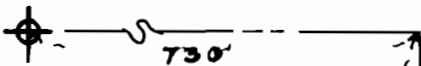

FND 1. PIN

ARABIAN

DRIVE

100.00'

0.07 ACS

IRRIGATED AREA: NW 1/4, NW 1/4 - 3.41 ACS

5 LATERALS

2" MAIN

NE 1/4, NW 1/4

U.S. HWY 395

867.46'

WELL

NOTE: WELL LOCATION BY SURVEY IS CHANGED FROM APPLICATION

BIRCH DRIVE

580'

636.14'

154.18'

L = 192.46'

210.79'

KRUMBEIN ENGINEERING LTD.
ENGINEERS — SURVEYORS — PLANNERS
361 S.E. Second Pendleton, Oregon

Scale

1" = 100'

Date

12-4-98

Drn. By

DHK

Ckd. By

Drng. No.

9882A

Job No.

955


Revision 1

Revision 2

FINAL PROOF SURVEY

QUESENBERRY

LOT 1, BLOCK 2
FIELDCREST ADDITION
NW 1/4, NW 1/4 AND NE 1/4, NW 1/4
SECTION 3, T.1 N., R.32 E.W.M.

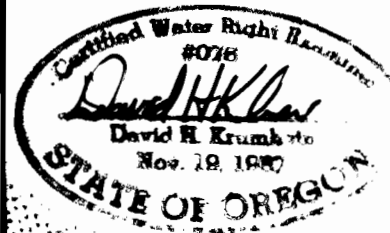

APPLICATION NO:
G-14007
PERMIT NO:
G-12803

RECEIVED

DEC 8 1998

WATER RESOURCES DEPT.
SALEM, OREGON

RENEWS 6/30/99