


Claim of Beneficial Use
Place of Use Map 1 of 3
 Permit S-7400 (Application S-9668)

- LEGEND**
- Place of Use (POU)
 - Freeways and Highways
 - Major Roads
 - Watercourses
 - Waterbodies

RECEIVED BY OWRD

NOV 08 2012


SALEM, OR

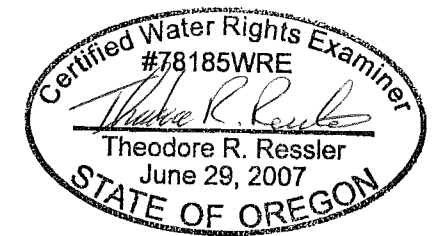

EXPIRES: 12-31-2012


DISCLAIMER

This map was prepared for the purpose of identifying the location of a water right only and it is not intended to provide legal dimensions or location of property ownership lines.

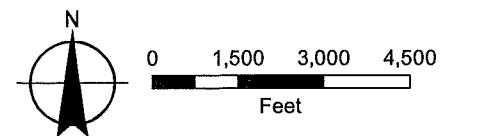

MAP NOTES:
 Date: November 1, 2012
 Data Sources: JUB Engineers, ESRI, OWRD



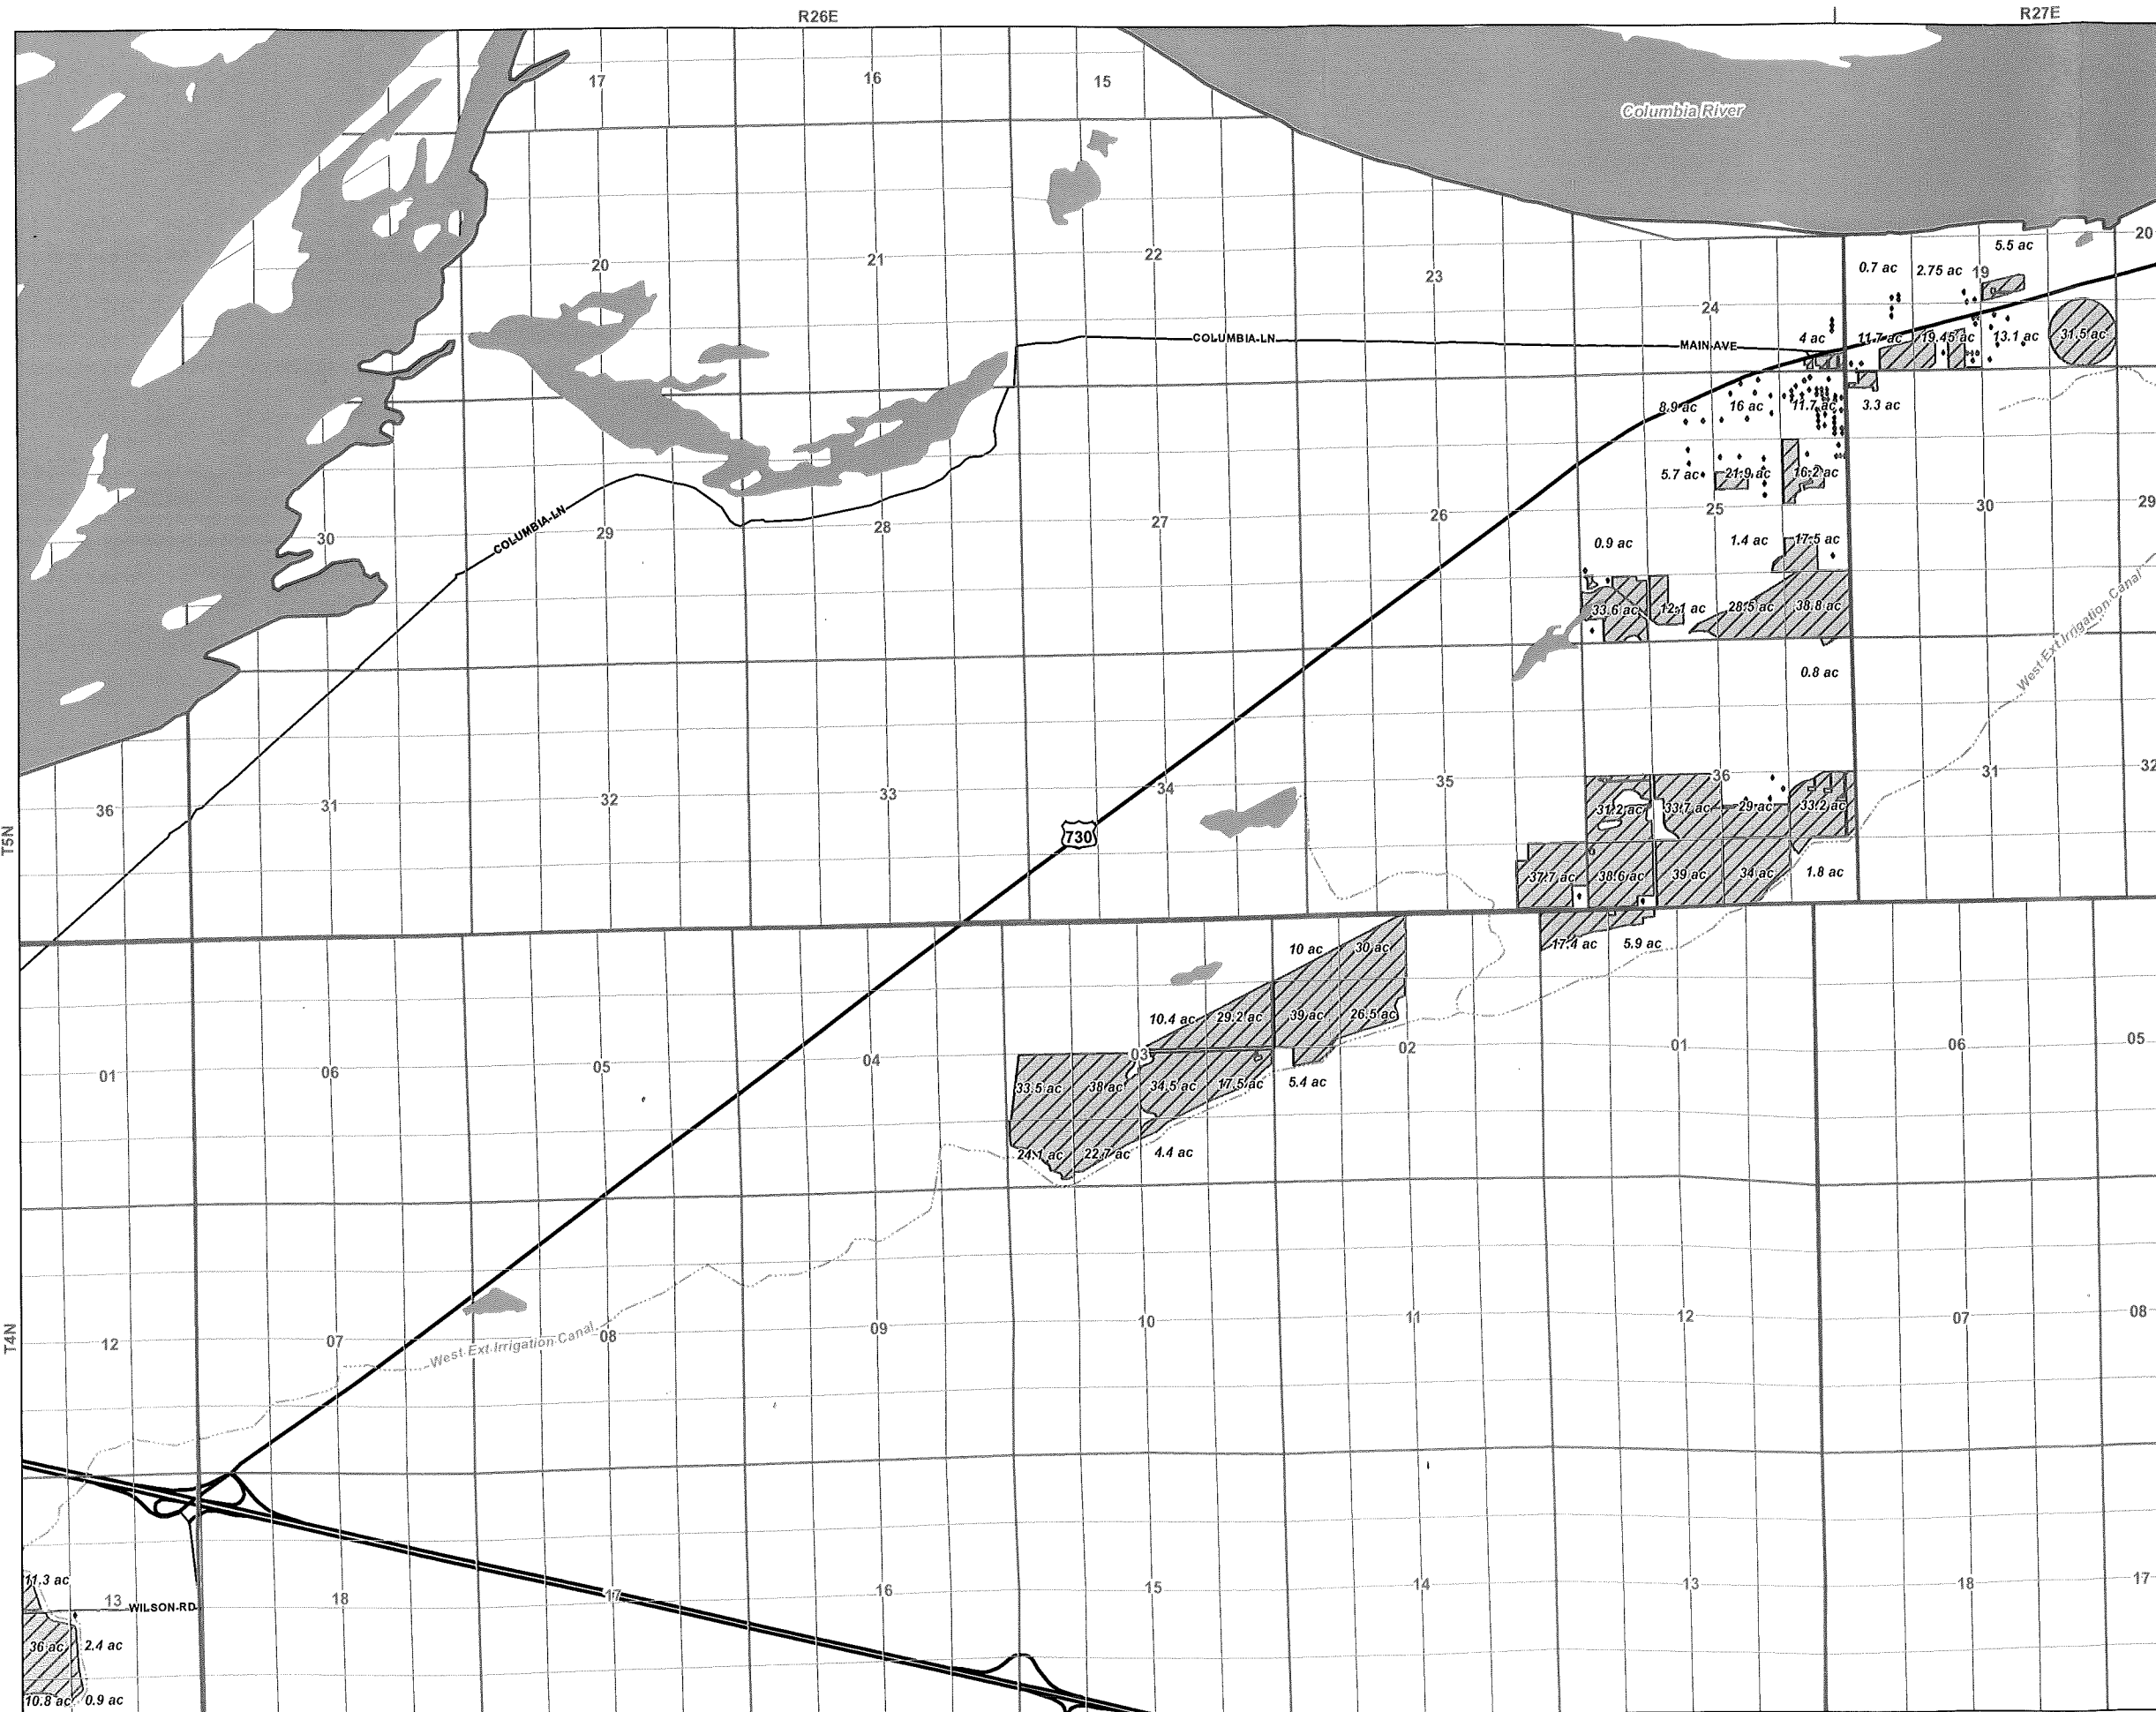


Claim of Beneficial Use
Place of Use Map 2 of 3
 Permit S-7400 (Application S-9668)

- LEGEND**
- Place of Use (POU)
 - Freeways and Highways
 - Major Roads
 - Watercourses
 - Waterbodies

RECEIVED BY OWRD
 NOV 08 2012
 SALEM, OR

Certified Water Rights Examiner
 #78185WRE
Theodore R. Ressler
 Theodore R. Ressler
 June 29, 2007
 STATE OF OREGON
 EXPIRES: 12-31-2012

DISCLAIMER
 This map was prepared for the purpose of identifying the location of a water right only and it is not intended to provide legal dimensions or location of property ownership lines.

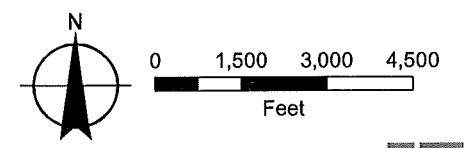






MAP NOTES:
 Date: November 1, 2012
 Data Sources: JUB Engineers, ESRI, OWRD





Claim of Beneficial Use
Place of Use Map 3 of 3
 Permit S-7400 (Application S-9668)


LEGEND

-  Place of Use (POU)
-  Freeways and Highways
-  Major Roads
-  Watercourses
-  Waterbodies

RECEIVED BY OWRD

NOV 08 2012


SALEM, OR

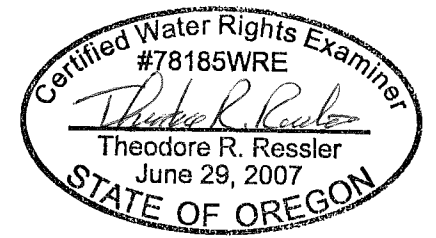

EXPIRES: 12-31-2012

DISCLAIMER

This map was prepared for the purpose of identifying the location of a water right only and it is not intended to provide legal dimensions or location of property ownership lines.

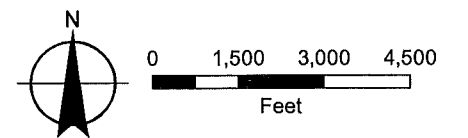

MAP NOTES:
 Date: November 1, 2012
 Data Sources: JUB Engineers, ESRI, OWRD

