

T.3,4S,R.12,13E,W.M.


FINAL PROOF SURVEY  
UNDER

Application No. 68644, Permit No. 50066  
IN NAME OF

PINE HOLLOW COOPERATIVE INC.

Surveyed MAY 7, 1996, by R.M. SUTTERFIELD

Lands not perfected  
under permit 50066  
(see T-10228)

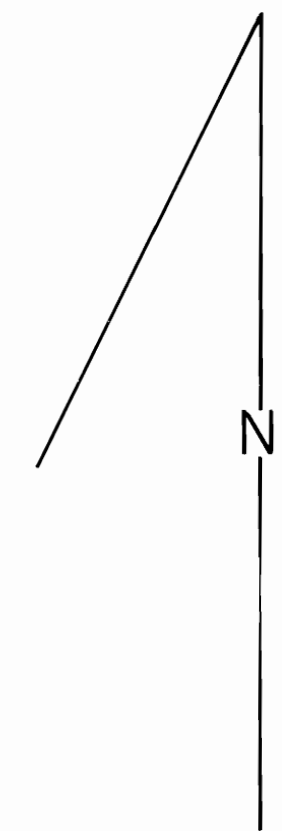

SCALE: 1"=1320'

DRAFTED 10/21, 22, 23/96 BY R.M.S. AC Shultz

