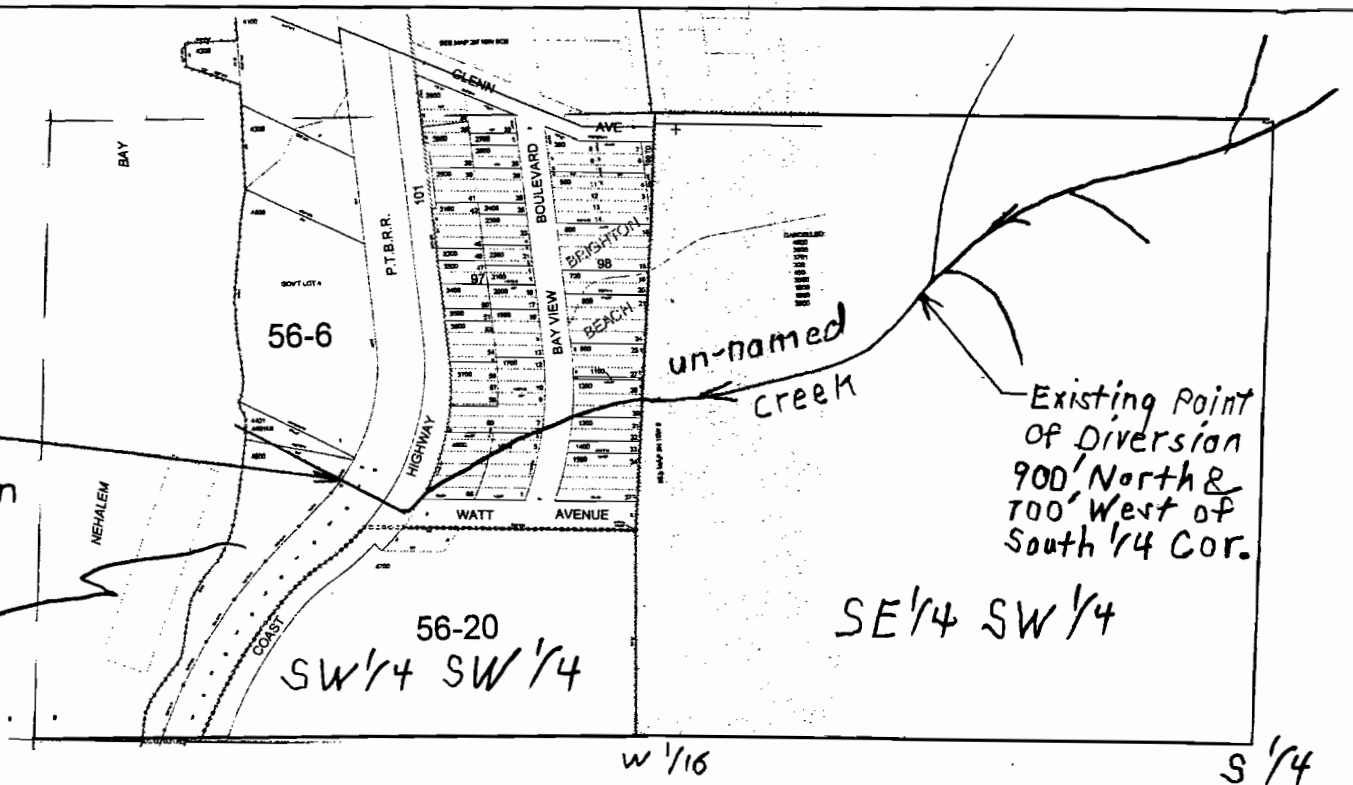




SCALE 1"=400'

NEW POINT OF DIVERSION
North 534' & West 615' From
West 1/16 Corner

Property - Existing
Place of Use



NOTES

THIS MAP DOES NOT CONSTITUTE A BOUNDARY SURVEY.
FOR BOUNDARY INFORMATION SEE MAP B-989 AND
A-4129, TILLAMOOK COUNTY SURVEY RECORDS.

THE PURPOSE OF THIS MAP IS TO SHOW THE LOCATION
OF THE NEW POINT OF DIVERSION FOR THE WATER
RIGHTS TRANSFER.

APPLICATION S 21876, PERMIT S 17904 AND CERTIFICATE
23644

USES ARE AS FOLLOWS:
ONE HOUSE AND ±0.5 ACRE IS BEING IRRIGATED.

SURVEY BY:
BAYSIDE SURVEYING ©
11765 HWY 101 SOUTH
TILLAMOOK, OR. 97141
(503) 842-5551

WATER RIGHTS MAP FOR:

RON AGRESTI
LANDS DESCRIBED IN DEED
INSTRUMENT NUMBER 2010-3868
TILLAMOOK COUNTY DEED RECORDS
SW 1/4, SW 1/4, SECTION 9, T.2N., R.10W., W.M.
TILLAMOOK COUNTY, OREGON

RECEIVED

SEP 10 2010
WATER RESOURCES DEPT
SALEM, OREGON

DATE	EQUIPMENT	FIELD	DRAWN	CHECKED	JOB NO.
AUG. 17, 2010	TOPCON GPT-3003W TDS NOMAD	TLJ/DWE	JDM	TLJ	

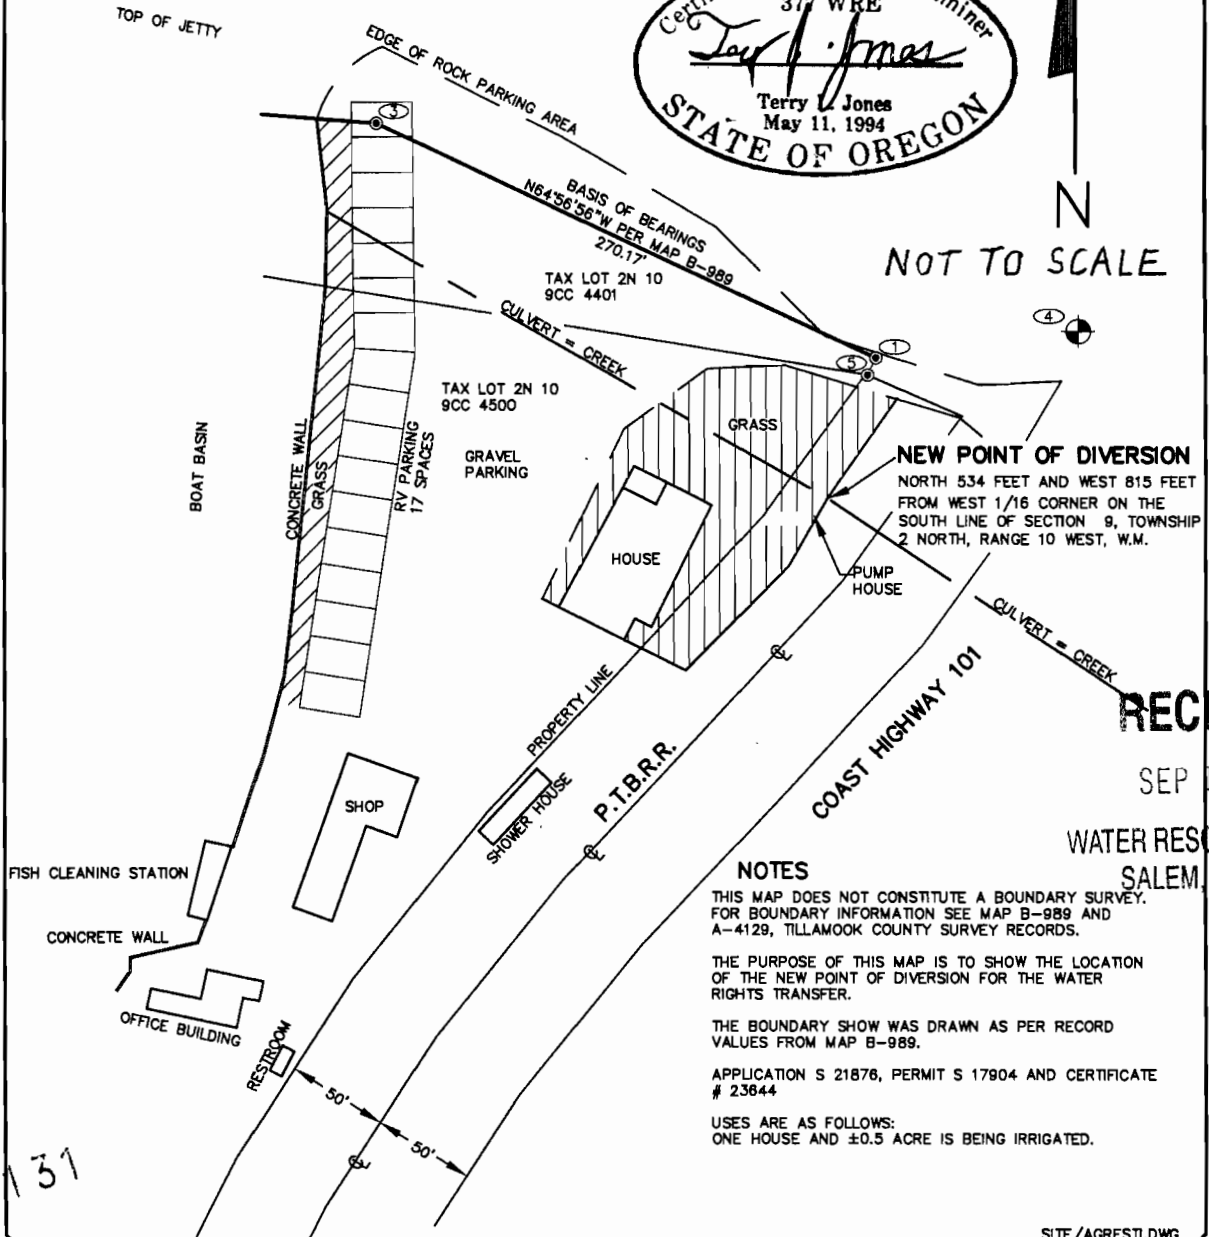
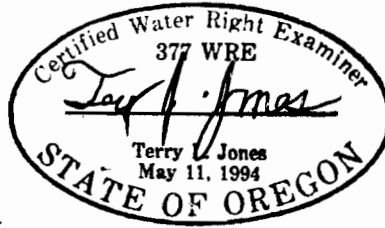
T 11131

BASIS OF BEARING

THE LINE BETWEEN THE FOUND MONUMENTS ① AND ③ AS SHOWN HEREON,
BEARS NORTH 64° 56' 56" WEST THE RECORD VALUE PER MAP B-989.

MONUMENT NOTES

- ① FOUND 2" IRON PIPE, 0.7' BELOW SURFACE, HELD.
- ③ FOUND 5/8" REBAR WITH YELLOW PLASTIC CAP MARKED "PLS 1205", 0.6' BELOW SURFACE, HELD, SEE MAP B-989.
- ④ FOUND 3" USGS BRASS DISK IN CONCRETE, ELEVATION = 23.46' (NGVD 1929) STAMPED "1 1933"
- ⑤ FOUND 5/8" REBAR WITH YELLOW PLASTIC CAP MARKED "PLS 1098", SMASHED, SEE MAP A-4129.

**RECEIVED**

SEP 10 2010

WATER RESOURCES DEPT
SALEM, OREGON**DETAIL MAP TO ACCOMPANY**

WATER RIGHTS MAP FOR:

RON AGRESTI

LANDS DESCRIBED IN DEED

INSTRUMENT NUMBER 2010-3868

TILLAMOOK COUNTY DEED RECORDS

SW 1/4, SW 1/4, SECTION 9, T.2N., R.10W., W.M.

TILLAMOOK COUNTY, OREGON

SITE/AGRESTI.DWG
AGRESTI.CR5

SURVEY BY:
BAYSIDE SURVEYING
11765 HWY 101 SOUTH
TILLAMOOK, OR. 97141
(503) 842-5551

DATE	EQUIPMENT	FIELD	DRAWN	CHECKED	JOB NO.
AUG. 17, 2010	TOPCON GPT-3003W TDS NOMAD	TLJ/DWE	JDM	TLJ	