


T.3S.R.2W.W.M.

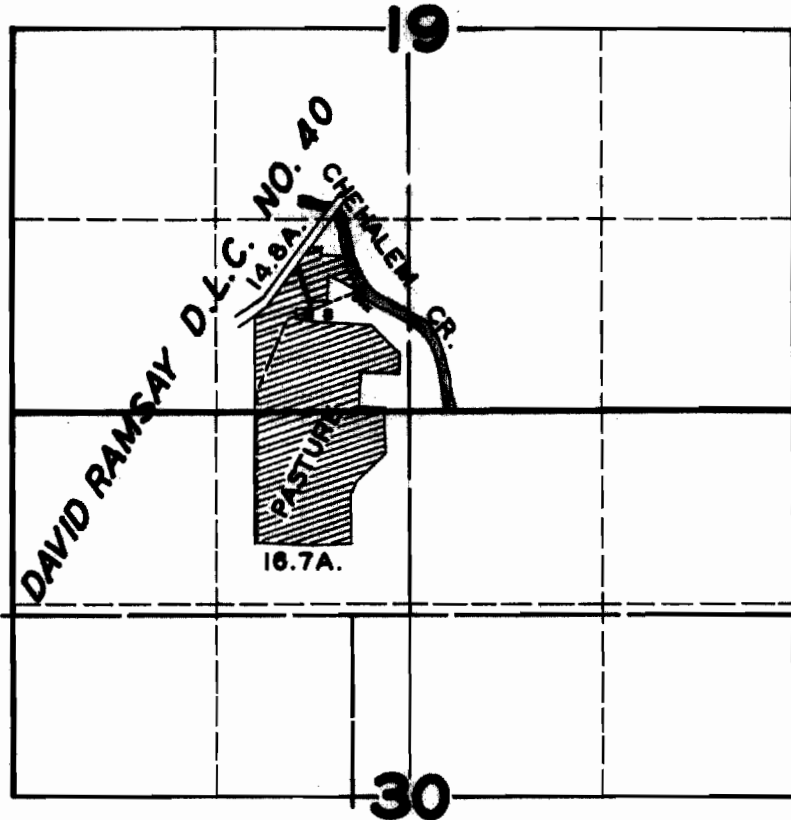

FINAL PROOF SURVEY
UNDER

Application No. 15722... Permit No. 11577...
IN NAME OF

CLARENCE ASCHE

Surveyed **MAR. 8** 1946, by **JAS. E. BUNNELL**