


- 1 Sid Green
- 2 W.E. Damon
- 3 A.L. Black
- 4 Hattie Cummings
- 5 Mrs. R.J. Stockdale
- 6
- 7 I. Hinshaw
- 8 I. M. Fogland
- 9 I. Hinshaw
- 10 Henrietta Wilson
- 11 " Wilson
- 12 Mabel Aldrich
- 13 Oral Hinshaw
- 14 George Aldrich
- 15 Herman Aldrich
- 16 Mrs. W.W. Fisher
- 17 Geo. Sigfrit
- 18 Alva Stockdale
- 19 Charlie Spraul
- 20 Rhider
- 21 Artia Stockdale
- 22 J. Lawrence

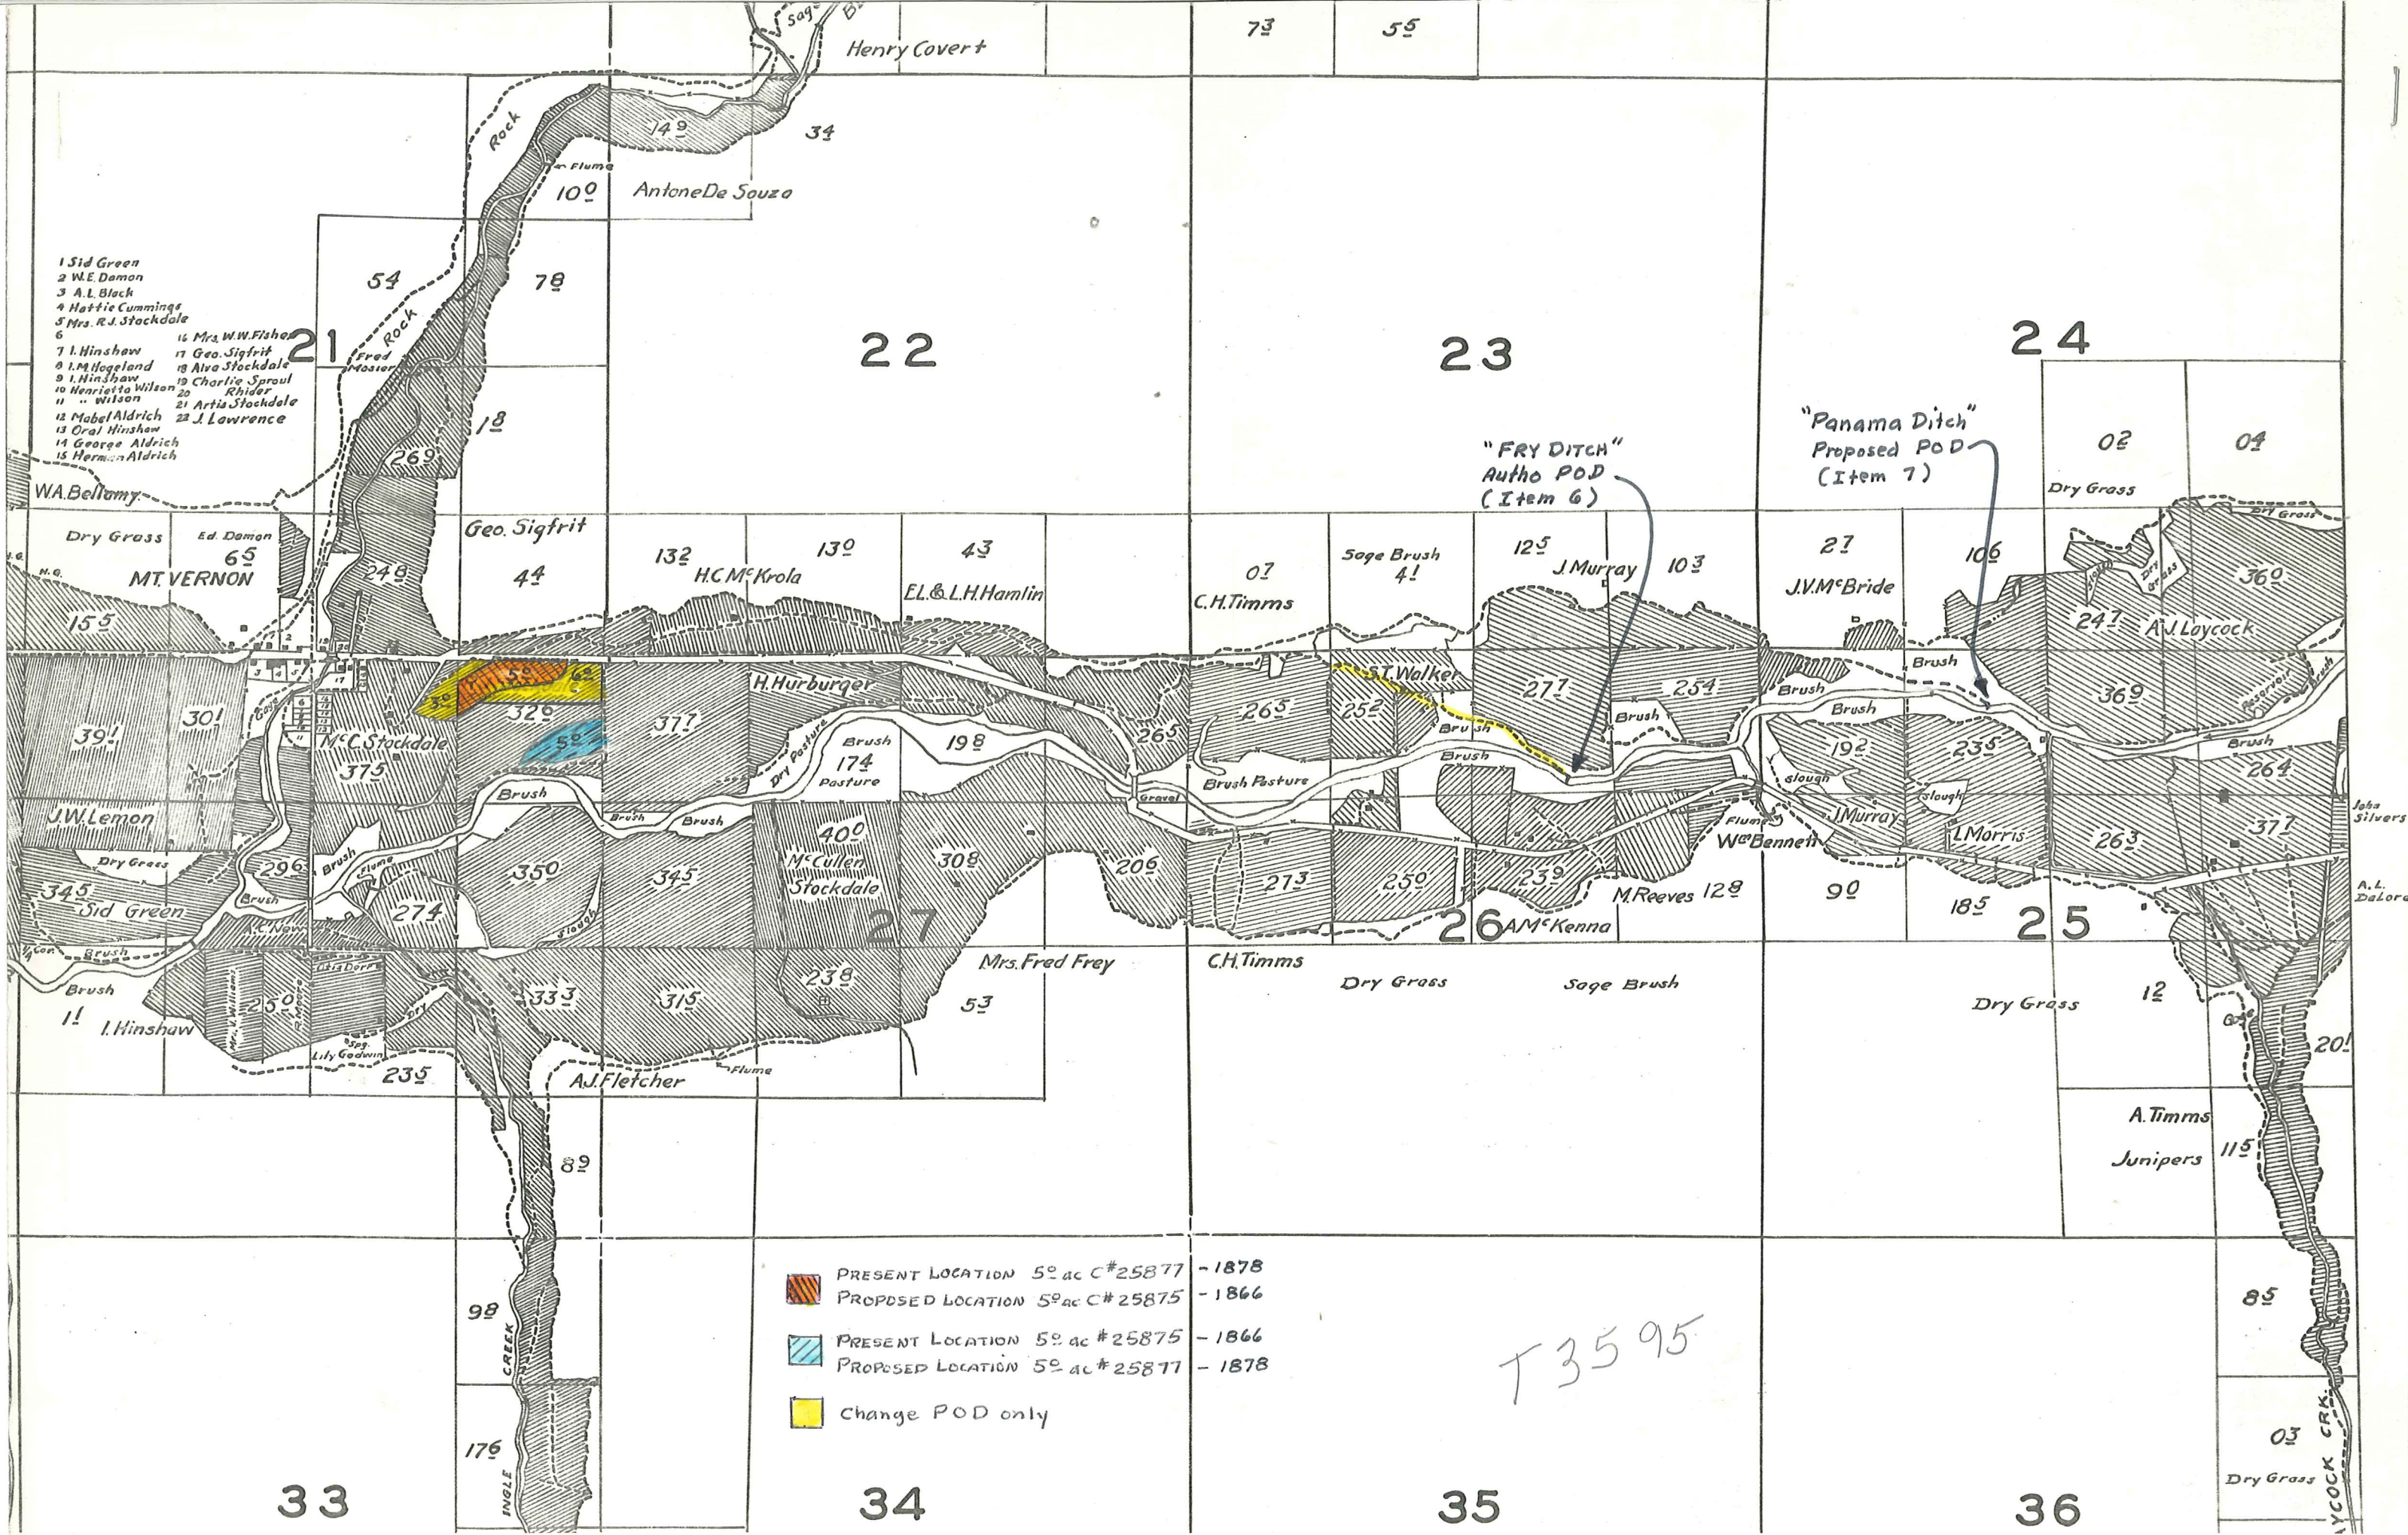

- PRESENT LOCATION 5⁰ ac C#25877 - 1878
- PROPOSED LOCATION 5⁰ ac C#25875 - 1866
- PRESENT LOCATION 5⁰ ac #25875 - 1866
- PROPOSED LOCATION 5⁰ ac #25877 - 1878
- Change POD only

T 3595