


REVISED CLAIM OF BENEFICIAL USE MAP
FOR

CHARLES K. KELLEY


SECTIONS 7 & 8
TOWNSHIP 39 SOUTH RANGE 19 EAST,
LAKE COUNTY, OREGON

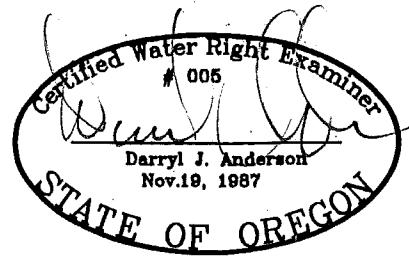

RENEWAL 12/31/13

LEGEND

- SECTION LINE
- 1/4 SECTION LINE
- 1/16 SECTION LINE
- IRRIGATION MAIN LINE
- DISTRIBUTION DITCH

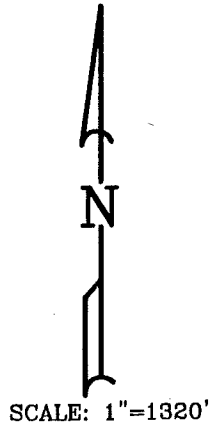

APPLICATION NO. S-54005
PERMIT NO. S-40411

NOTE:
PREPARATION OF THIS MAP IS FOR IDENTIFYING PROPOSED
WATER RIGHTS ONLY. IT HAS NO INTENT TO PROVIDE
LOCATIONS OR DIMENSIONS OF PROPERTY BOUNDARIES.

RECEIVED BY OWRD

JAN 16 2013

REVISION	BY
2/08/12	RC

ANDERSON ENGINEERING
AND SURVEYING, INC.
P.O. BOX 28
LAKEVIEW, OREGON 97630
(541) 947-4407
FAX: 947-2321

FOR:
CHARLES K. KELLEY
P.O. BOX 711
LAKEVIEW, OR 97630
541-947-3000

CLAIM OF BENEFICIAL USE MAP
APPLICATION NO. S-54005
PERMIT NO. S-40411

DATE:	11/02/11
SCALE:	1"=1320'
DWG. BY:	R.C.
JOB:	2011-001
FILE:	S40411
SHEET:	1 OF 1

