


FINAL PROOF SURVEY MAP

JELD WEN INC.

Application G-14900 Permit G-13725


T 37 S R 10 E, W.M. Sections 19-20-30

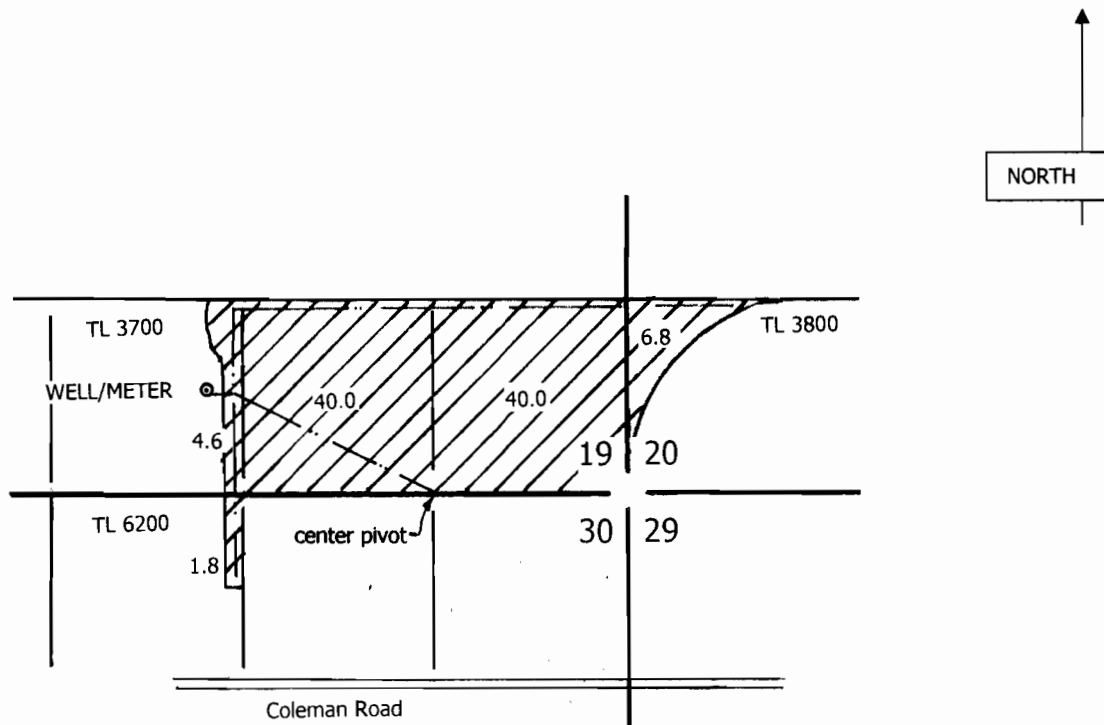

Well/Meter ○
 Tax Lot line _____
 Section Line _____
 1/4 1/4 Line _____
 Pipe line _____

Well /Meter: 720' N & 240' W
 from the S 1/4 corner Section 19

Scale 4" = 1 mile

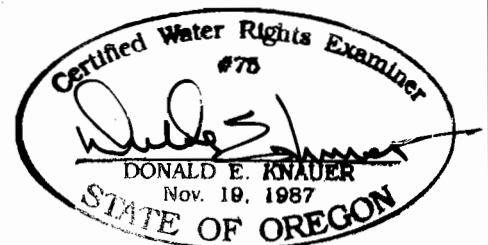

This map is not intended to provide legal dimensions or locations of property ownership lines.

RENEWAL DATE: 6-30-2011