
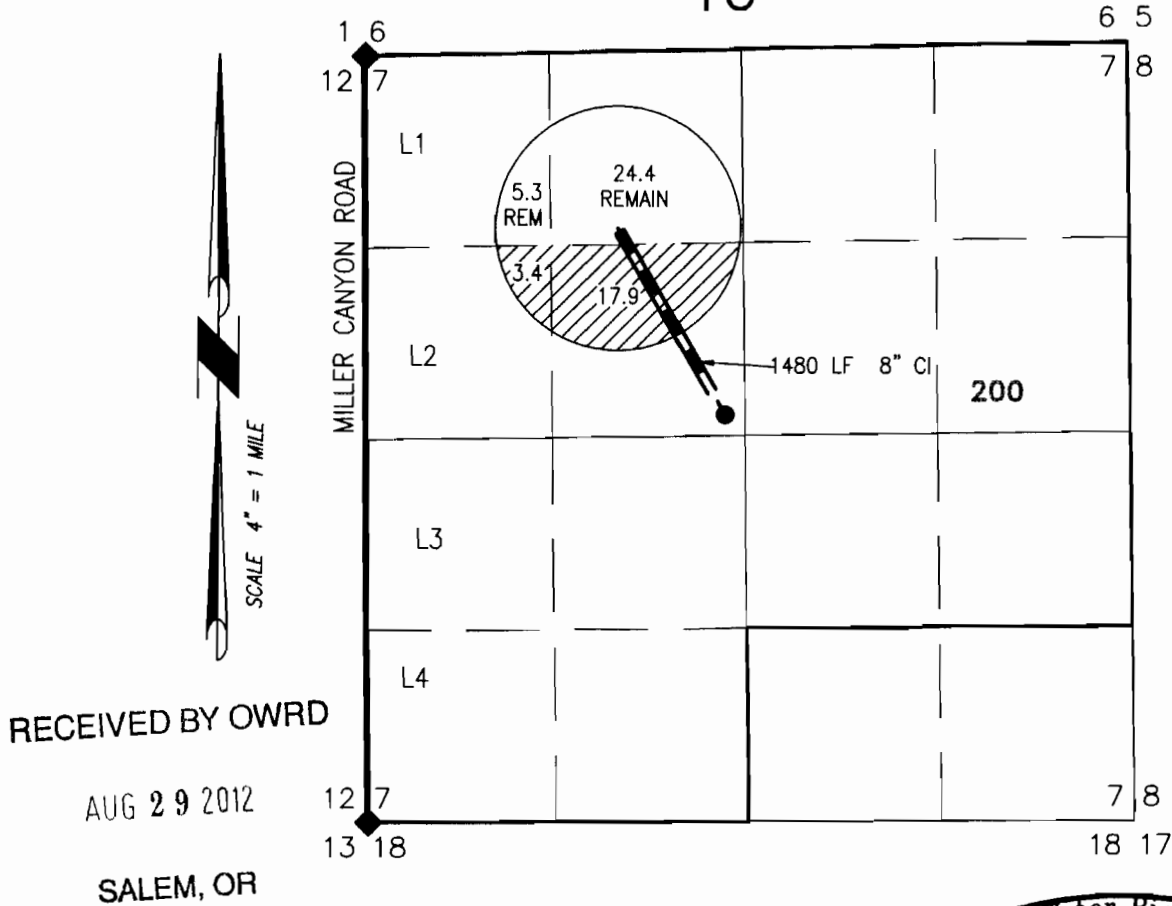


TRANSFER MAP TO ACCOMPANY APPLICATION TO CHANGE PLACE OF USE FOR MEADOW CREEK ENTERPRISES

TAX LOT 200
IN SECTION 7, TOWNSHIP 23 SOUTH, RANGE 27 EAST, W.M.
HARNEY COUNTY, OREGON

"TO"

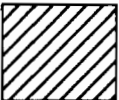

 21.3 ACRES IRRIGATION FROM WELL 1
(C #60960), AS SHOWN

 BURIED 6 OR 8 INCH STEEL PIPE

● #1
WELL #1 (HARN 260) PERMIT: G-8055
2820' NORTH & 2440' EAST FROM THE SW
CORNER SECTION 7.



RENEWAL DATE: 12/31/2012

THIS MAP IS FOR THE PURPOSE OF LOCATING A WATER
RIGHT ONLY AND HAS NO INTENT TO PROVIDE LEGAL
DIMENSIONS OR THE LOCATION OF PROPERTY LINES.

PROJECT No. 12-031

PREPARED AT THE REQUEST OF:
RICHARD RANEY
67337 SILVER CREEK RD.
RILEY, OR 97758


**ALL POINTS ENGINEERING
& SURVEYING, INC.**



P.O. BOX 767 (CRR)
TERREBONNE, OREGON 97760
(541) 548-5833 PH
(541) 585-4602 FX
www.APEandS.com

1000070

T. 23S., R. 27E., W.M.
"FROM"

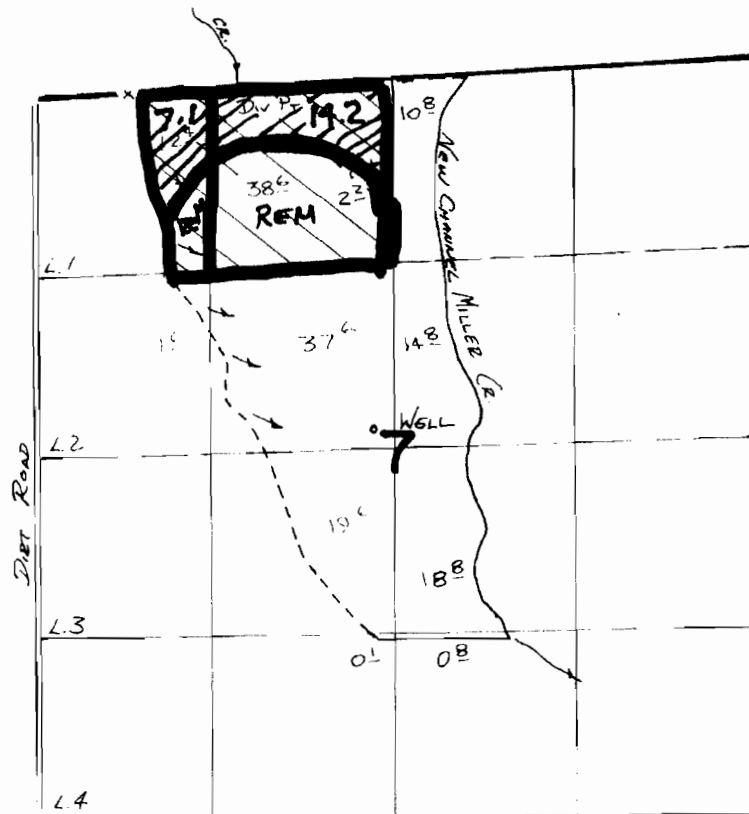

RECEIVED BY OWRD

AUG 29 2012

SALEM, OR



SCALE 1" = 1320'

Div. Pt. Loc: 1450 E. FROM NW CORNER SEC 7

Well Loc: 2820' N. & 2440' E. FROM SW COR. SEC. 7

FINAL PROOF SURVEY
 UNDER

RECEIVED BY OWRD

G-8642

G-8055

Application No. **57249** Permit No. **43009**
 IN NAME OF

SEP 06 2012

SALEM, OR

MEADOW CREEK ENTERPRISES

Surveyed 5-6 1988, by B.W. Bishop

41025-179-13R

V.L.C.

1011471


Raney Water Right Exhibit

Aerial imagery from USDA FSA Summer 2011



Legend

- TwnRng
- Section
- TRS_QQ
- POU
- POD

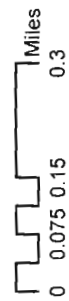

Scale 1:1,000,000

RECEIVED BY OWRD

SEP 06 2012

SALEM, OR

1011471

TRANSFER MAP TO ACCOMPANY APPLICATION TO CHANGE PLACE OF USE FOR MEADOW CREEK ENTERPRISES



TAX LOT 200
IN SECTION 7, TOWNSHIP 23 SOUTH, RANGE 27 EAST, W.M.
HARNEY COUNTY, OREGON

RECEIVED BY OWRD

NOV 26 2012

SALEM, OR

"TO"

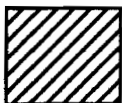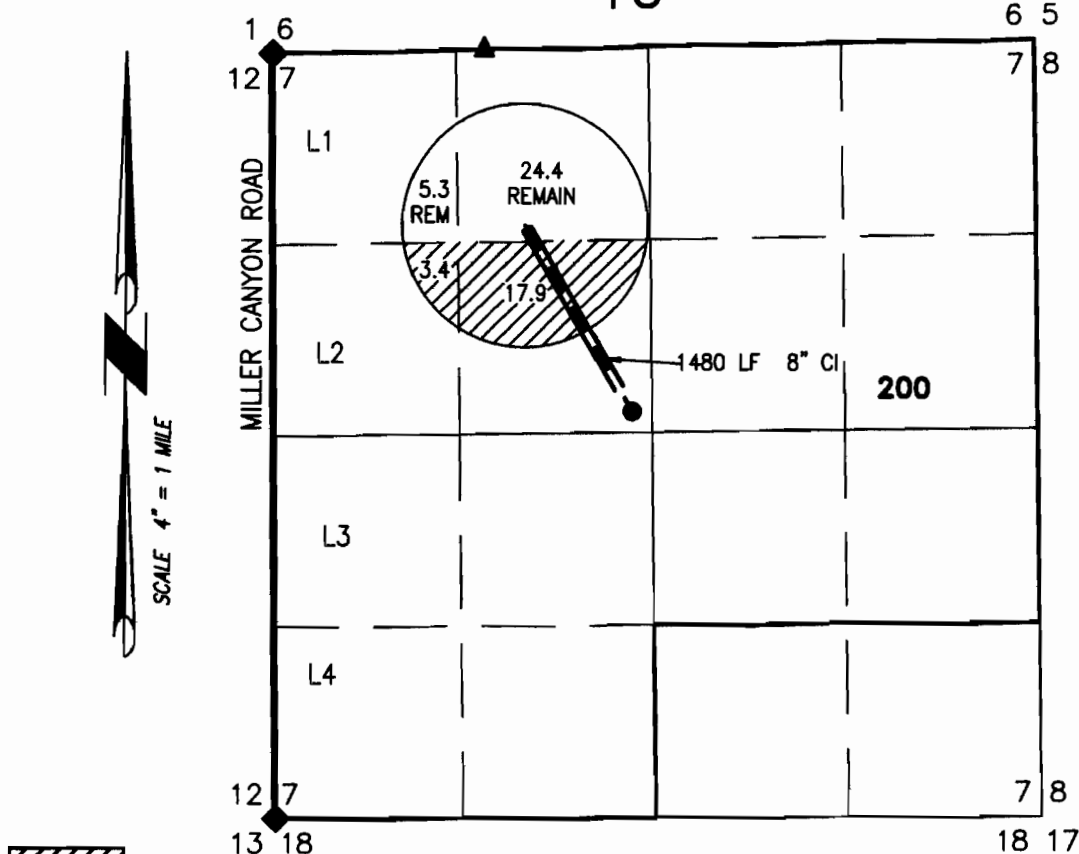


21.3 ACRES IRRIGATION FROM WELL 1 (C #60960) & POD 1 (C #60961), AS SHOWN



BURIED 6 OR 8 INCH STEEL PIPE

- ▲ **POD #1**
PERMIT: S-43009
1450' EAST FROM THE NW CORNER SECTION 7.
- **WELL #1**
(HARN 260) PERMIT: G-8055
2820' NORTH & 2440' EAST FROM THE SW CORNER SECTION 7.

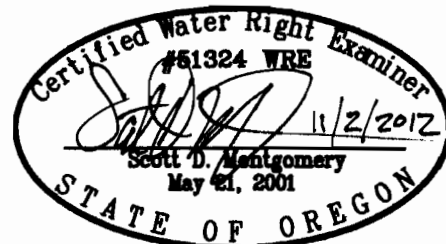

RENEWAL DATE: 12/31/2012

THIS MAP IS FOR THE PURPOSE OF LOCATING A WATER RIGHT ONLY AND HAS NO INTENT TO PROVIDE LEGAL DIMENSIONS OR THE LOCATION OF PROPERTY LINES.

PROJECT No. 12-031

PREPARED AT THE REQUEST OF:
RICHARD RANEY
67337 SILVER CREEK RD.
RILEY, OR 97758

**ALL POINTS ENGINEERING
& SURVEYING, INC.**



P.O. BOX 767 (CRR)
TERREBONNE, OREGON 97760
(541) 548-5833 PH
(541) 585-4602 FX
www.APEandS.com