


CLAIM OF BENEFICIAL USE

TRANSFER T-8948

IN THE NAME OF: JAMES W. & HELEN M CHRISTOPHERSON

TOWNSHIP 39 SOUTH, RANGE 3 WEST, W.M.

JACKSON COUNTY, OREGON

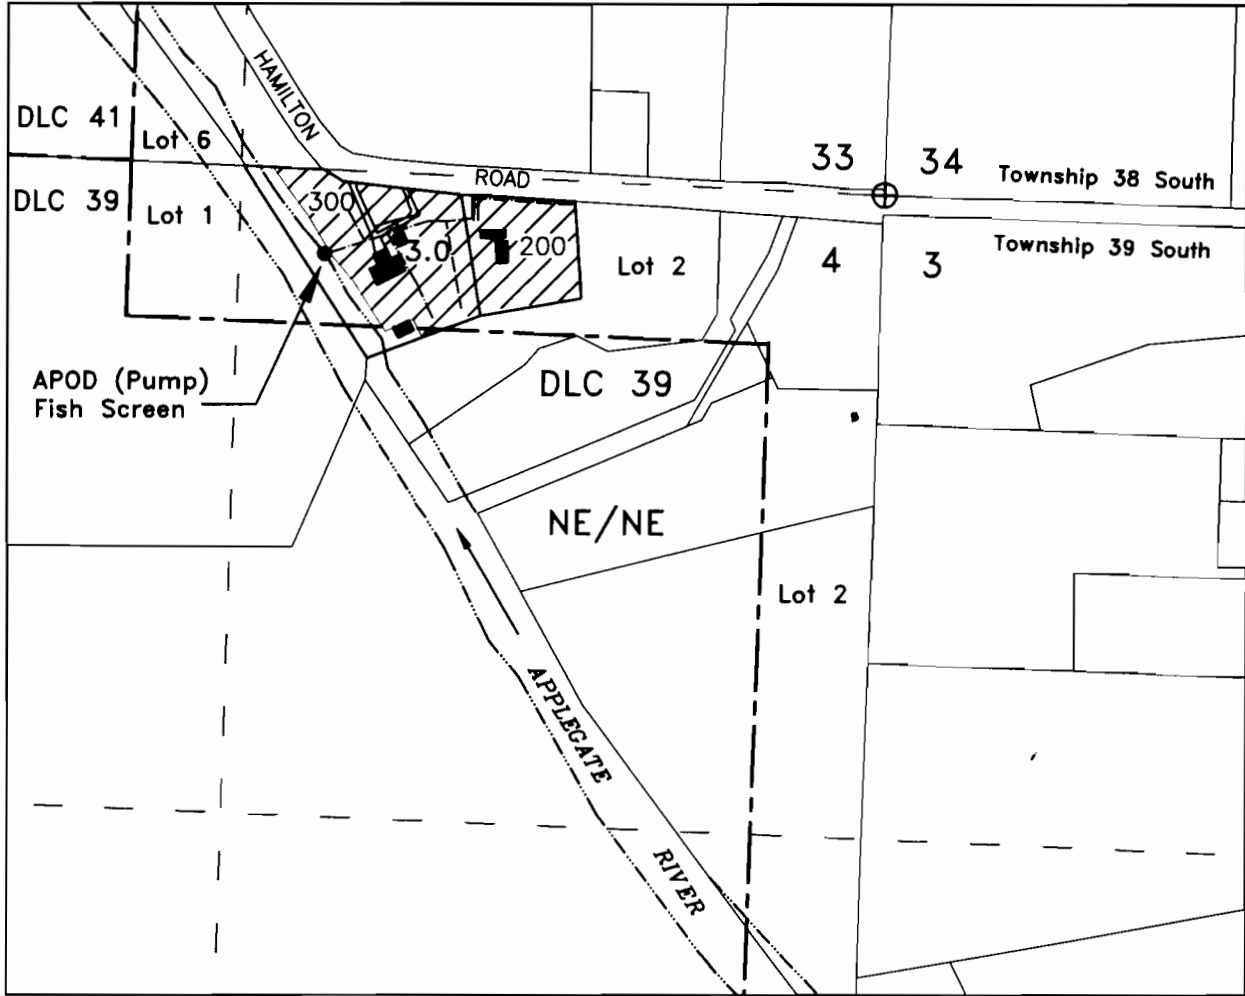


ADDITIONAL POINT OF DIVERSION

APOD - NE/NE, Lot 2, 175 feet South & 1160 feet West from the NE corner of Section 4, Township 39S Range 3W, WM

Existing POD (of record) - NE/NE, Section 14, Township 39 South, Range 3 West, W.M., 350 feet South & 900 feet West from the NE corner of Section 14



Place of Use 3.0 Acres - Irrigation
Tax Lot 200 & 300

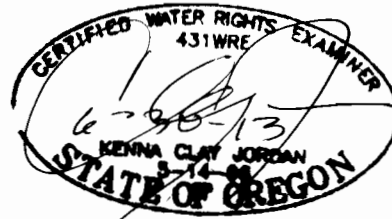

NORTH

Scale

1" = 400'

This map is not intended to provide legal dimensions or locations of property ownership lines

Base map - Jackson County GIS on 2005 FSA & 2010 Google aerial photo overlay for assumed best fit

JORDAN ENGINEERING
460 JORDAN LANE
ROSEBURG, OR 97471
(541) 673-1931

Drawn 1/30/2012 n.s.d.
Revised 3/30/2012 n.s.d.
Revised 4/06/2012 hnj