


Township 5 South, Range 1 East, W.M.
Portions of Sections 2 & 11

RECEIVED

FILED

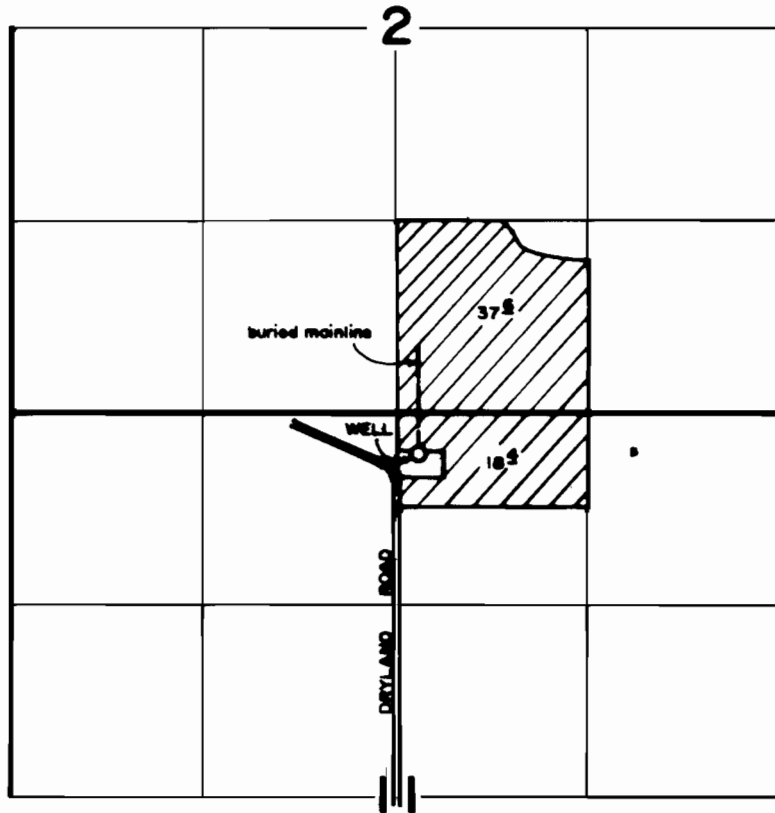

WELL LOCATED 290' S. and 150' E. from N. 1/4 cor. Sec. 11.

FINAL PROOF SURVEY

under

Appl. No. G-12776, Per. No. G-11674

in the name of

BUTSCH BROS.

June 2, 1995



THIS MAP WAS PREPARED FOR THE PURPOSE OF IDENTIFYING THE LOCATION OF A WATER RIGHT ONLY AND IS NOT INTENDED TO PROVIDE LEGAL DIMENSIONS OR LOCATION OF PROPERTY OWNERSHIP LINES.