

T. 8 & 9 S., R. 25 E., W.M. TRANSFER

RECEIVED

JUN 29 1987

APPLICATION MAP FOR
ROBERT M. ORDWAY
ELEANOR M. ORDWAY

WATER RESOURCES DEPT
SALEM, OREGON


T-5968

APPROVED

OLD POD 858' N & 2970' W of SE
corner Sec. 33, T8S, R25E
NEW POD 1030' S & 30' W of NE
corner Sec. 6, T9S, R25E



SCALE
4" = 1 mi

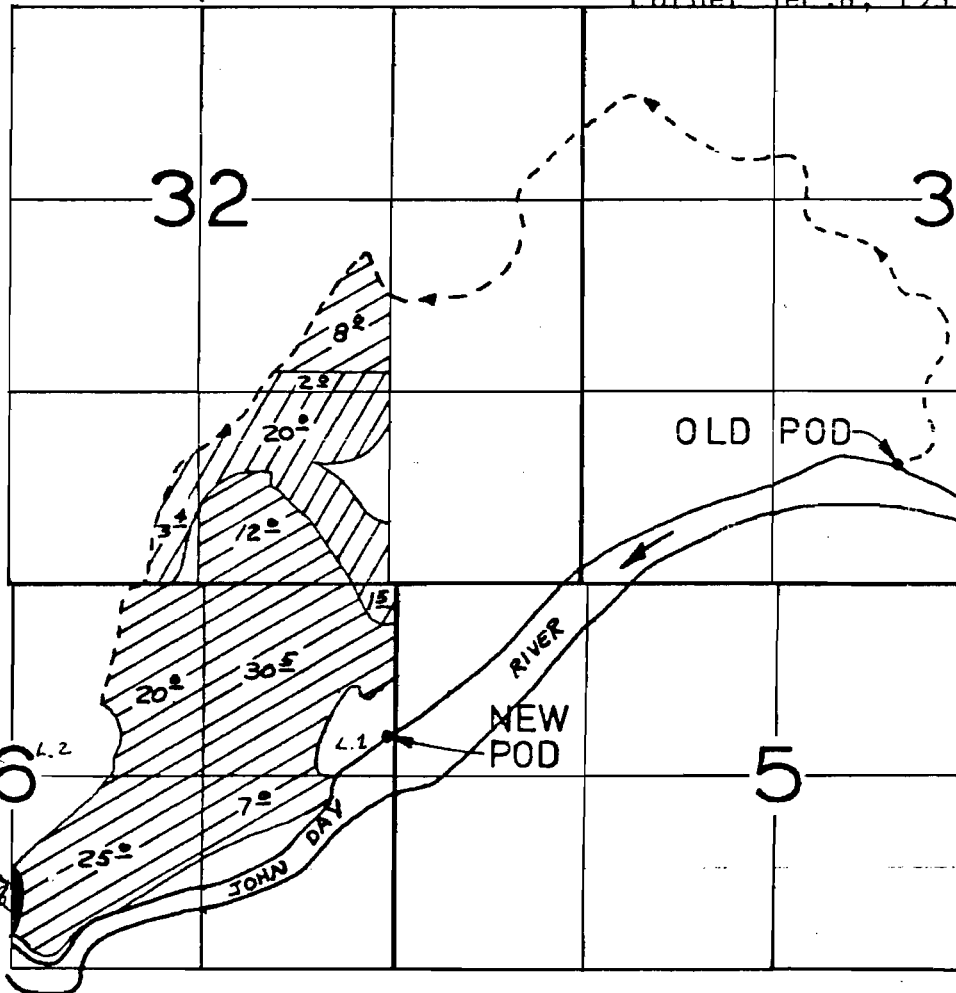

see remarks
0.6 acre under
Cert. 51880
Div. 1560' N
& 1870' E from
sw corn. Sec. 6
T9S, R25E WM


 C-25955 Primary  C-25955 Supplemental

T. 8 and 9 S., R. 25 E., W.M.

RECEIVED

MAR 31 1997

WATER RESOURCES DEPT.
SALEM, OREGON

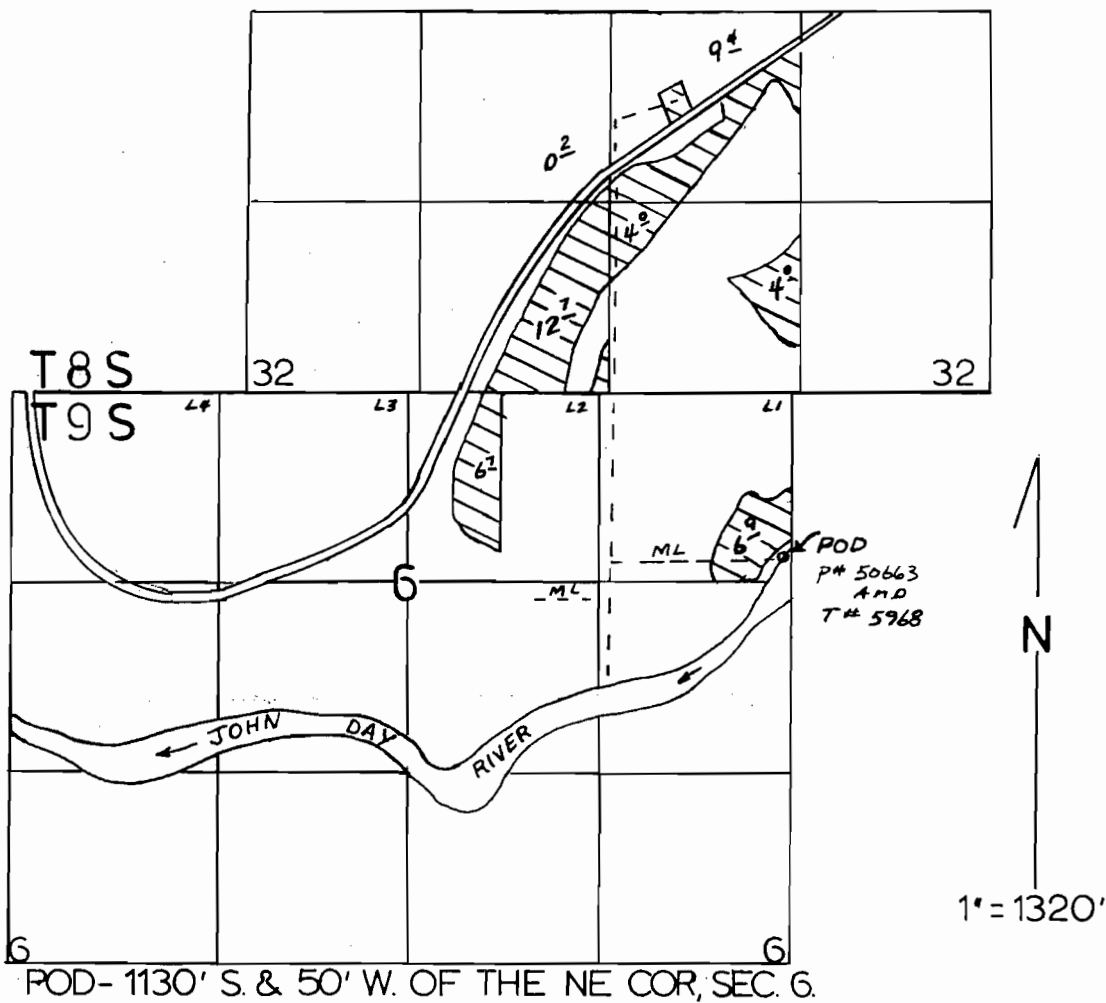

FINAL PROOF SURVEY

UNDER

Application No. 69170 Permit No. 50663 & POD TRAN. 5968

IN NAME OF

ROBERT M. AND ELEANOR M. ORDWAY

Surveyed May 18, 1995, by L. Miller

Revised FPM
T 5968 3/97