


RECEIVED

NOV 24 2010

REGISTERED SURVEYOR  

**T.33S.R7W. W.M.**

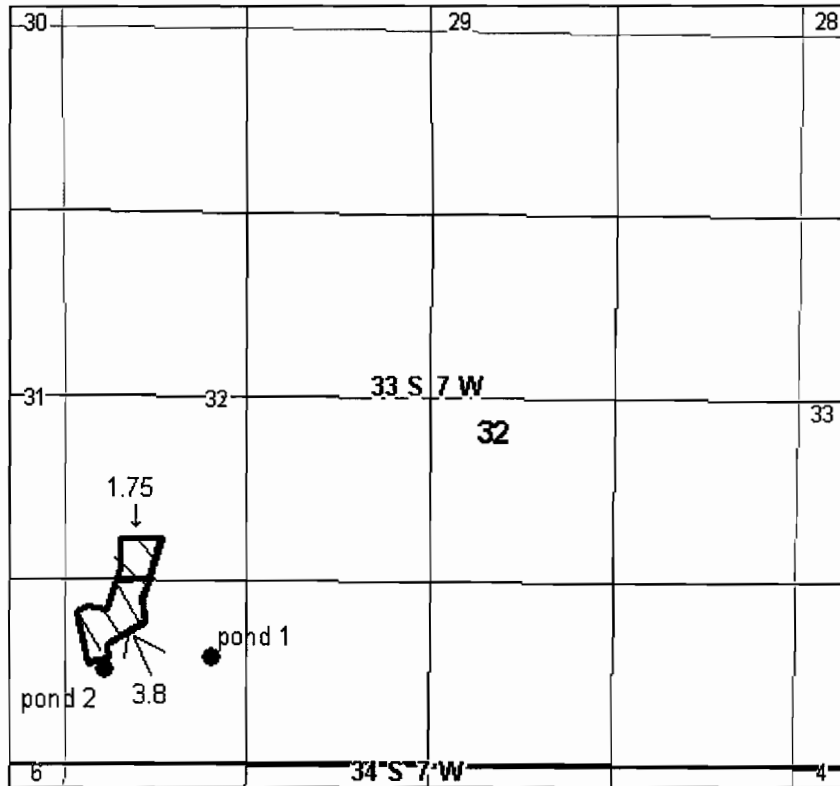

**FINAL PROOF SURVEY  
UNDER**

**Application No. G-10525 Permit No. G-9745**

**IN NAME OF  
Nick C. Weber**

**SURVEYED MAY 8, 1989, by B Sue James**

Pond 1 is 1056 ft. east and 756 ft north of SW corner Sec. 32.

Pond 2 is 296 ft. east and 671 ft. north from SW corner Sec. 32

1 inch = 1,320 feet