THIS MAP WAS PREPARED FOR ASSESSMENT PURPOSE ONLY

SECTION 3 T.4S. R.8W. W.M.
TILLAMOOK COUNTY
1" = 400'

4S 8 3

SEE MAP 3S 8

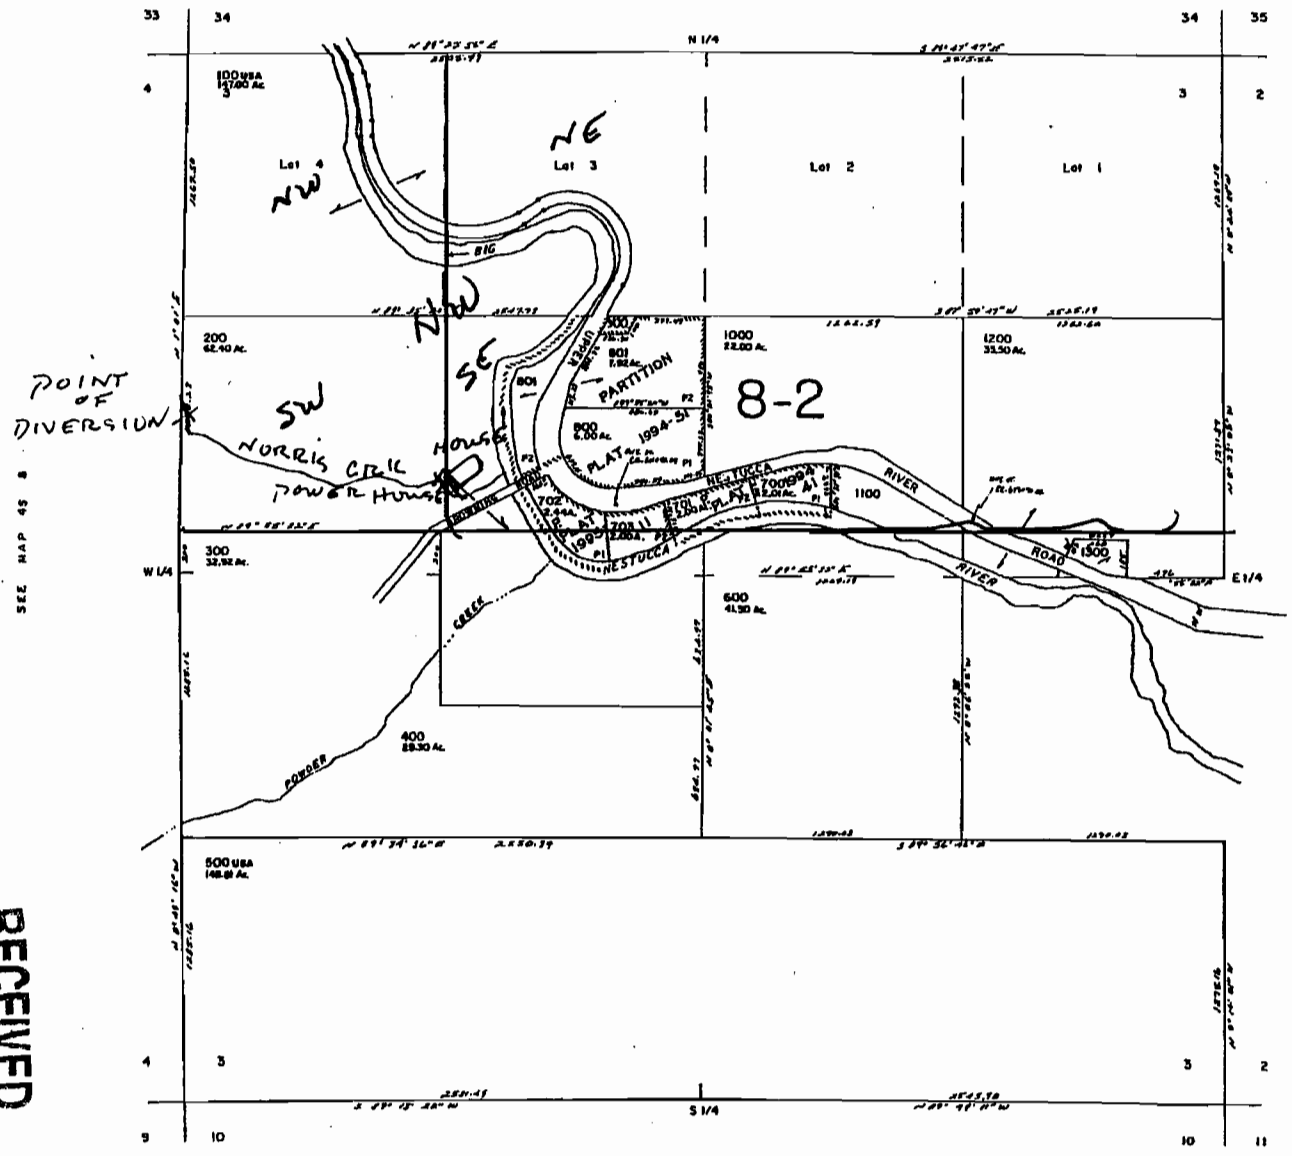

SEE MAP 4S 8

SEE MAP 4S 8

SEE MAP 4S 8

4S 8 3

REVISED 2-25-99, BPH

RECEIVED
JUN 28 2012
WATER RESOURCES DEPT
SALEM, OREGON