



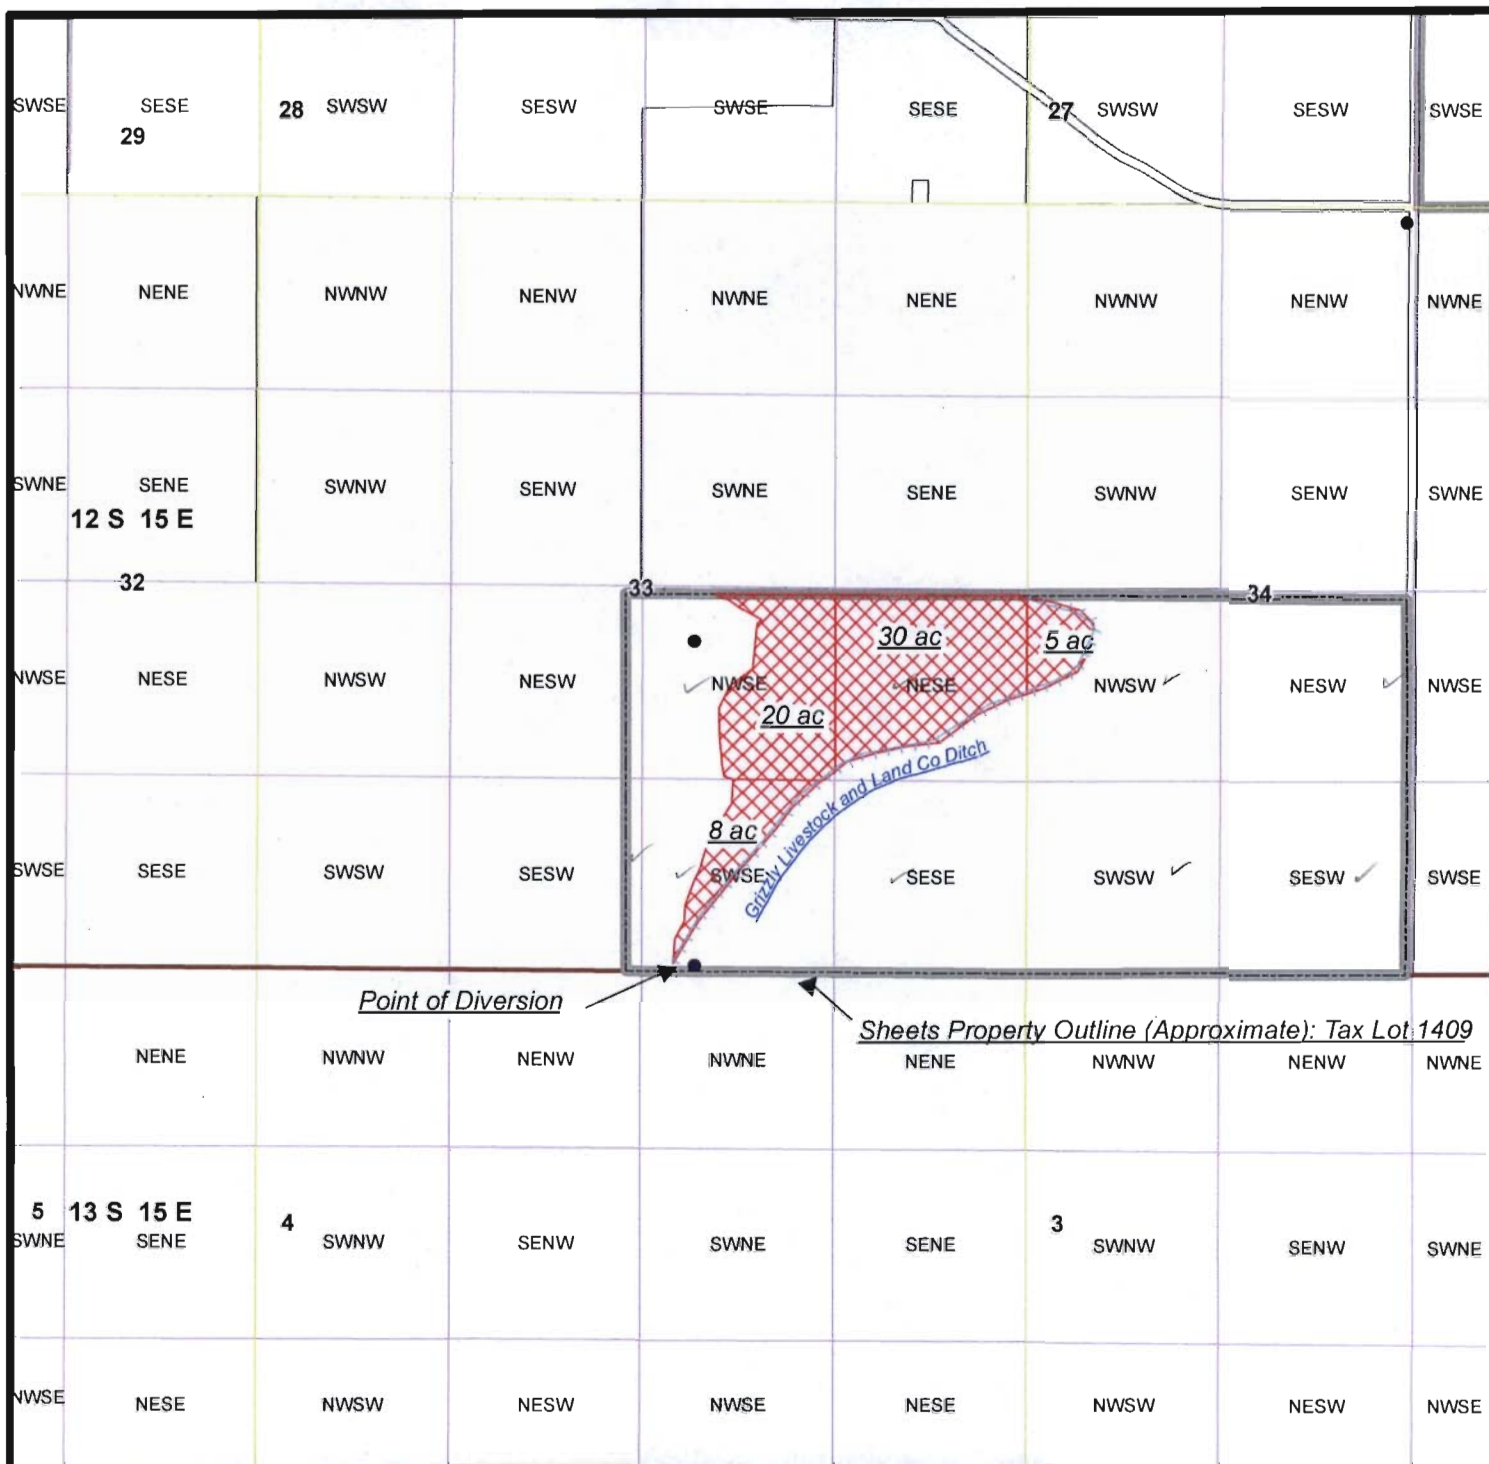

1 Inch = 1/4 Mile

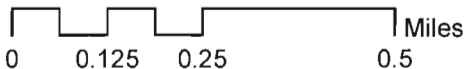

Cancellation Map for David Sheets

-  Certificate 2321 Cancel 63 Acres
-  Sheet_property
-  Townships
-  Sections
-  Quarter quarters

RECEIVED BY OWRD

FEB 07 2013

SALEM, OR

Map Disclaimer:
This product is for informational purposes
and may not have been prepared for, or be suitable
for legal, engineering, or surveying purposes. Users of
this information should review or consult the
primary data and information sources to ascertain
the usability of the information.
This map is not intended to display property lines


Disclaimer: This listing is the result of a manual search of the records of the Watermaster's Plat Cards and the
WRIS database. The listing has not been field checked. That a right is of record is no guarantee that it has not
been abandoned under the conditions of ORS 540.610. The plat card records of listed by the 40.0 acre quarter-
quarter within a section. If the water right listed within a quarter-quarter is on more than one tax lot, this office has
not itemized that water rights for each tax lot - only a survey could accurately depict how much of the water rights
are on each tax lot.

Map made by David Bates, Assistant WM Dist 11 Bend oR

01-09-2013



1 Inch = 1/4 Mile

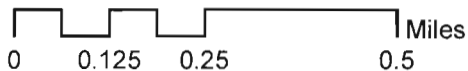

Cancellation Map for David Sheets

- Certificate 2321 Cancel 63 Acres
- Sheet_property
- Townships
- Sections
- Quarter quarters

RECEIVED BY OWRD

FEB 07 2013

SALEM, OR

01-09-2013


Map Disclaimer:
This product is for informational purposes
and may not have been prepared for, or be suitable
for legal, engineering, or surveying purposes. Users of
this information should review or consult the
primary data and information sources to ascertain
the usability of the information.
This map is not intended to display property lines

Disclaimer: This listing is the result of a manual search of the records of the Watermaster's Plat Cards and the
WRIS database. The listing has not been field checked. That a right is of record is no guarantee that it has not
been abandoned under the conditions of ORS 540.610. The plat card records of listed by the 40.0 acre quarter-
quarter within a section. If the water right listed within a quarter-quarter is on more than one tax lot, this office has
not itemized that water rights for each tax lot - only a survey could accurately depict how much of the water rights
are on each tax lot.

GRIZZLY LIVE STOCK AND LAND COMPANY. DITCH

SCALE 1 INCH = 40 CHS.

App. 3425
Per 2012

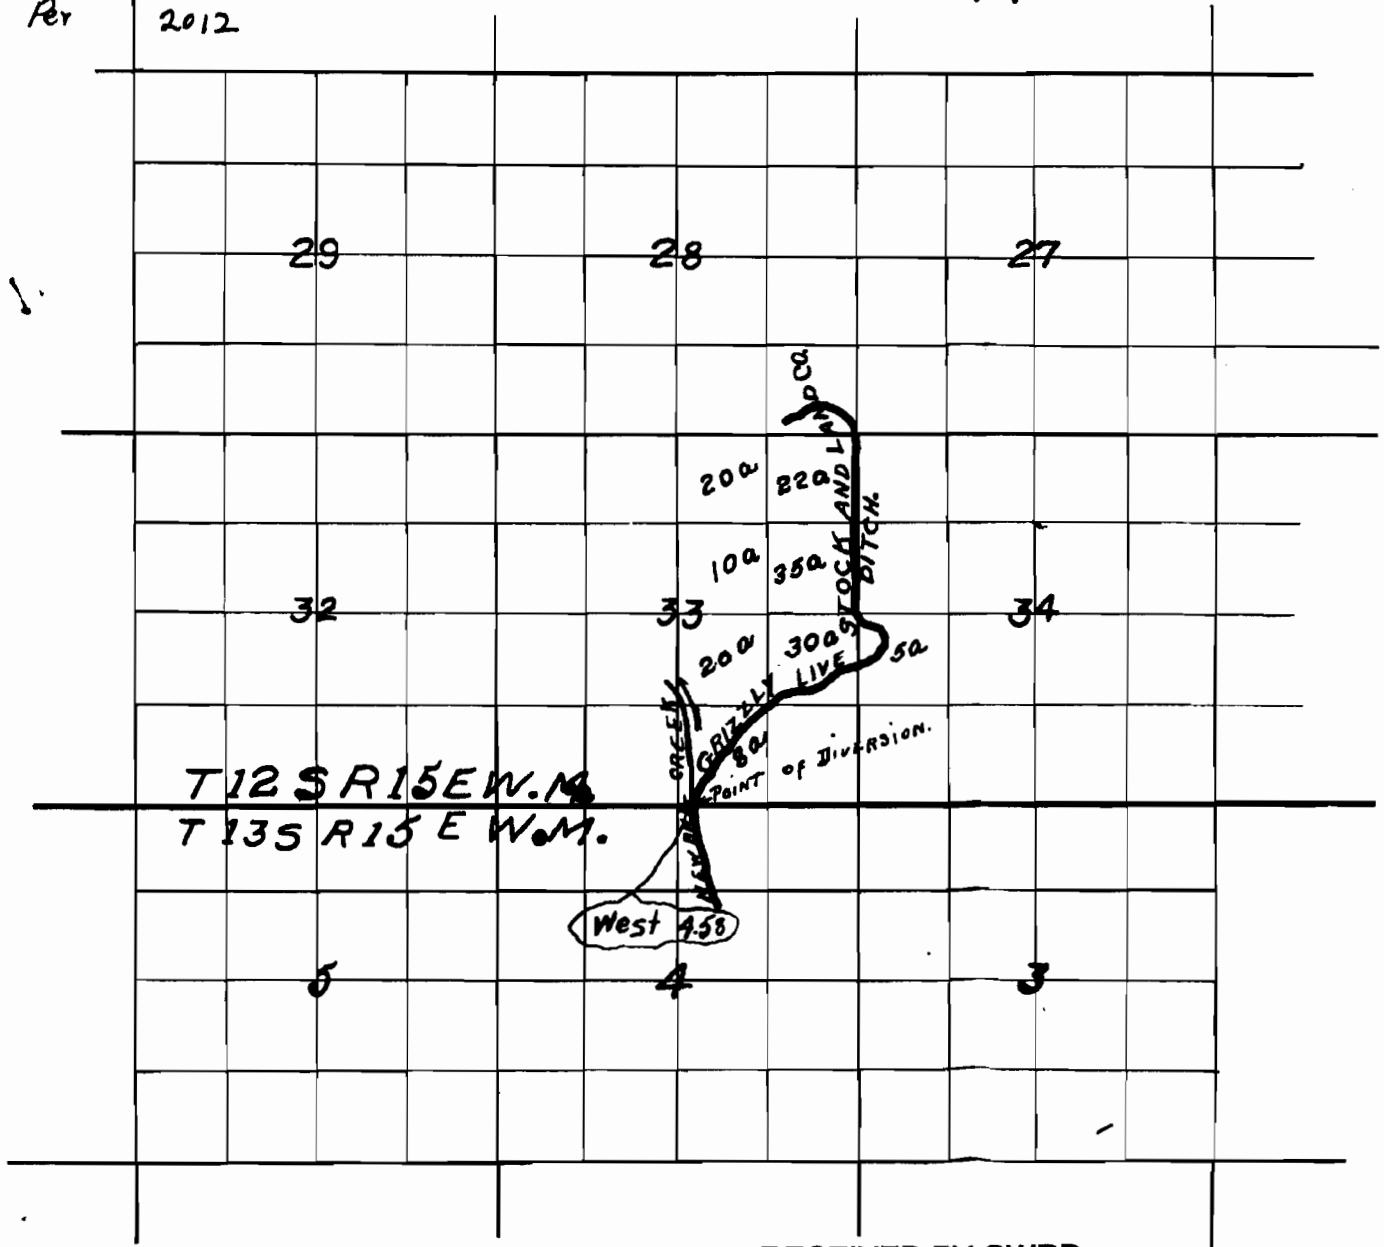

RECEIVED BY OWRD

FEB 07 2013

SALEM, OR

2012

ACCT #	MAP ID
692	121500000100
693	121500000200
694	121500000300
695	121500000400
696	121500000401
697	121500000500
698	121500000600
699	121500000700
700	121500000800
701	121500000900
702	121500001000
703	121500001100
704	121500001200
705	121500001300
706	121500001400
709	121500001403
710	121500001404
711	121500001405
712	121500001406
713	121500001407
714	121500001408
12894	121500001409
12779	121500001410
12778	121500001411
13232	121500001413
13265	121500001414
17355	121500001415
715	121500001500
716	121500001600
717	121500001700
718	121500001800
719	121500001900
12240	121500001901
12241	121500001902
17557	121500001903
18382	121500001905
18383	121500001906
720	121500002000
721	121500002100
722	121500002200
723	121500002300
724	121500002400
725	121500002500
726	121500002600
727	121500002601
728	121500002602
729	121500002603
730	121500002604
17349	121500002605
731	121500002700
732	121500002800
733	121500002900
734	121500003000
735	121500003100
736	121500003101
737	121500003300
738	121500003400
739	121500003500
740	121500003501
741	121500003700
742	121500003800
743	121500003801
744	121500003900
745	121500004000

THIS MAP WAS PREPARED FOR
ASSESSMENT PURPOSE ONLY


0 1,000 2,000 3,000 4,000 Feet

T.12S. R.15E. W.M.
JEFFERSON COUNTY
1" = 2000'

Lot 2321

12.15

CANCELLED:
1401
1402
3200
3600
3994
1412

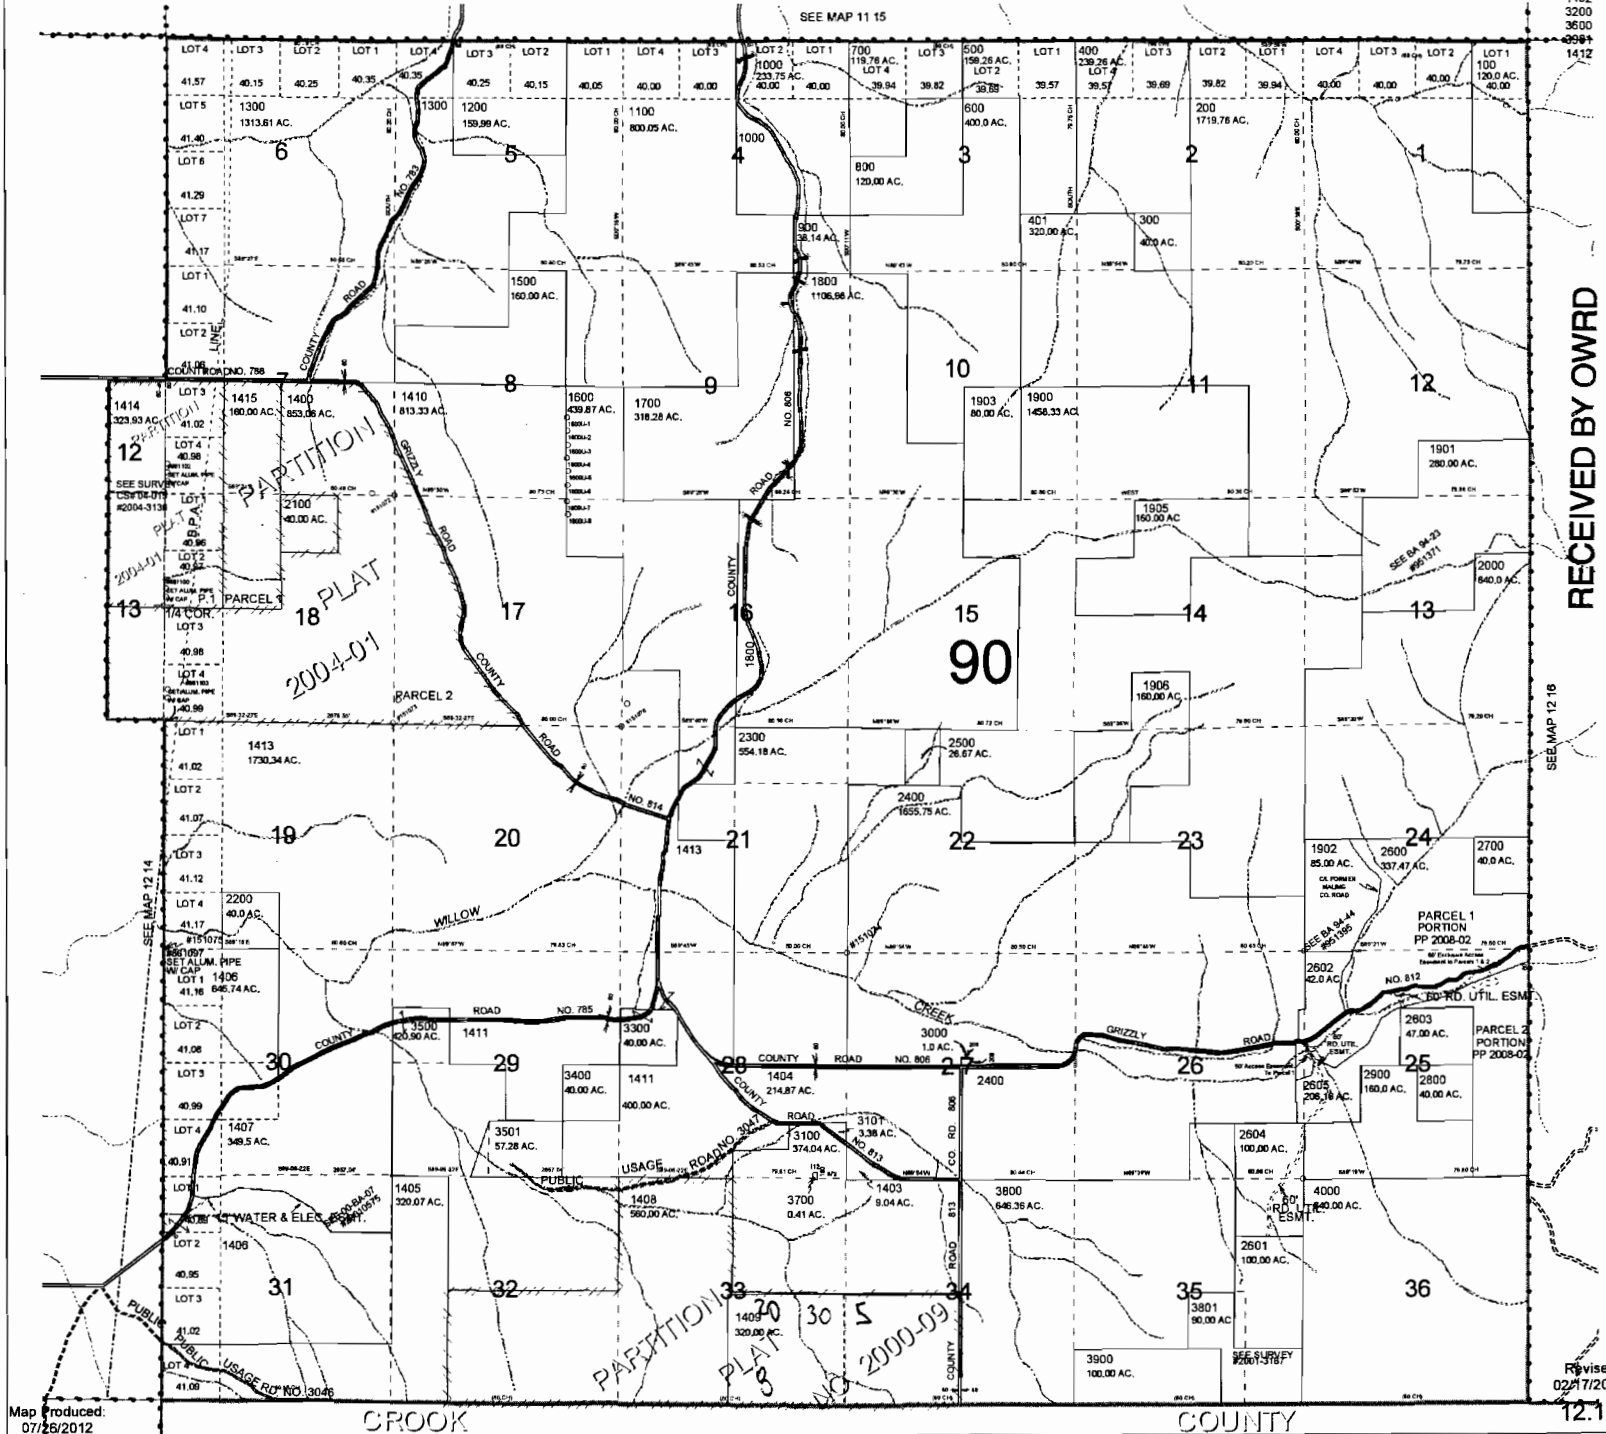

Map Produced:
07/26/2012

Revised
02/17/2011

12.15