


T.23S.R.10W.W.M.

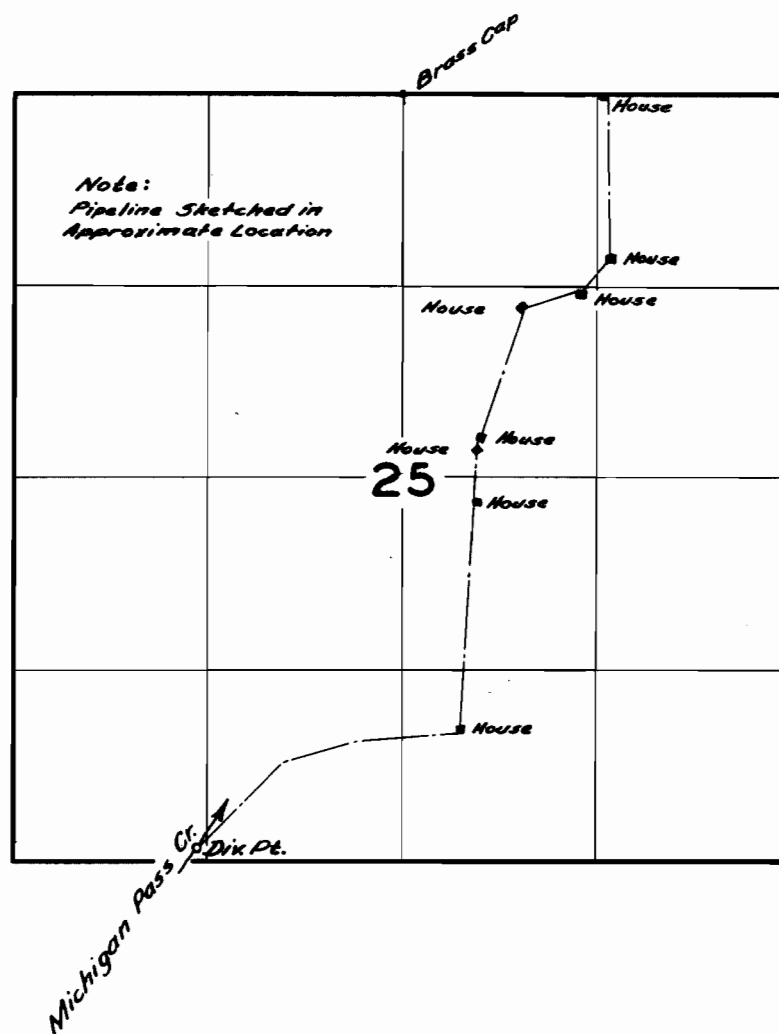

FINAL PROOF SURVEY
UNDER

Application No. 29442 Permit No. 23177
IN NAME OF

Helen M. Judy, et al.

Surveyed June 22 1968, by C.D. Baugh