

*This map prepared to show irrigation system as actually constructed and the lands actually irrigated.  
Prepared Aug. 18 1930.*

**MAP OF  
J. H. BOOTH IRRIGATION SYSTEM  
Sections 11 & 12, T. 295. R. 6W & 7 & 8, T. 295. R. 5W. WM.  
DOUGLAS COUNTY, OREGON**


*Office of Ben. B. Irving, Civil Engineer and Surveyor.*

**CERTIFICATE OF ENGINEER.**

*I, Ben. B. Irving, of Roseburg, Oregon, do hereby certify that this map was made from notes taken during an actual survey made by me August 13 & 14 1926, and that it correctly represents the works described in the accompanying application, together with the location of all streams and other ditches in the immediate vicinity*

*Ben. B. Irving  
Registered Professional Engineer.*

*Oregon No. 240  
November 8 1919.*

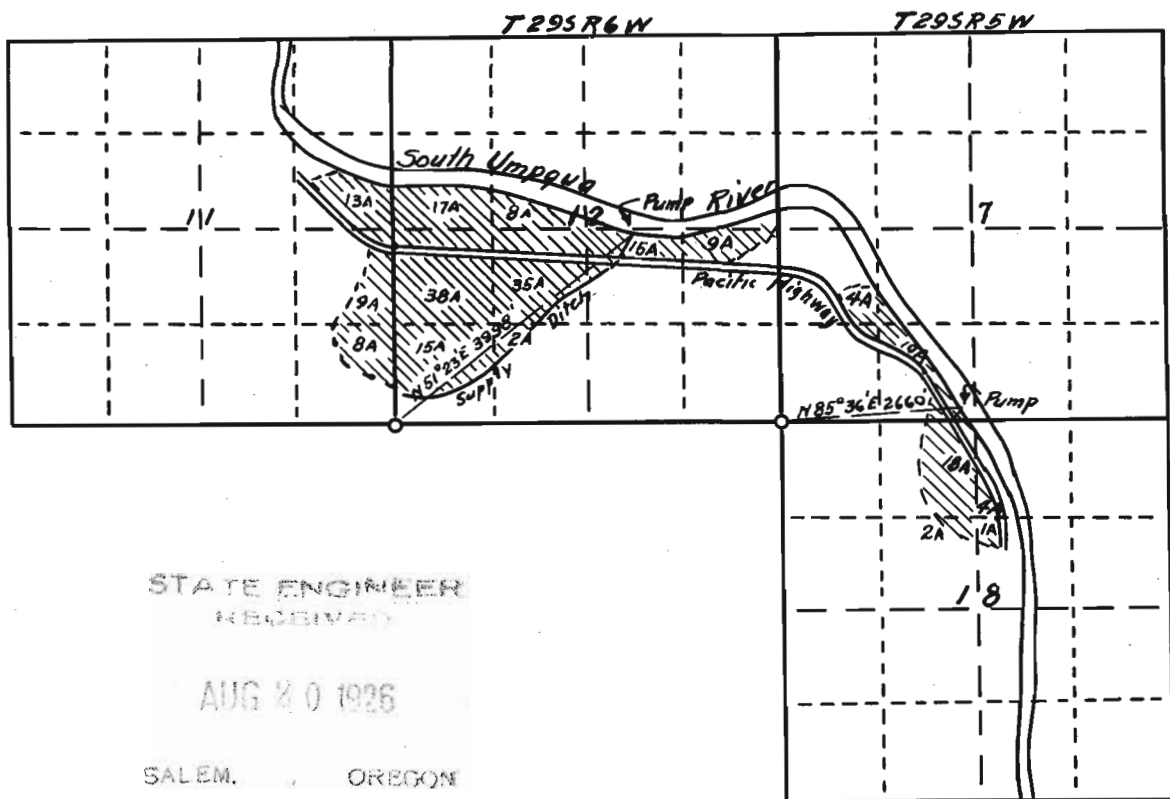

**MAP OF**  
**J. H. BOOTH IRRIGATION SYSTEM**  
 Sections 11 & 12, T.29SR6W. & 7 & 8, T.29SR5W W.M.  
 DOUGLAS COUNTY, OREGON.

*Office of Ben B. Irving, Civil Engineer and Surveyor.*

**CERTIFICATE OF ENGINEER.**

*I, Ben B. Irving, of Roseburg, Oregon, do hereby certify that this map was made from notes taken during an actual Survey made by me August 13 & 14, 1926, and that it correctly represents the works described in the accompanying application, together with the location of all streams and other ditches in the immediate vicinity*

*Ben B. Irving*

*Registered Professional Engineer*

*Oregon No. 240*

*November 8, 1919*

Application No. 11039  
 Permit No. 7528