
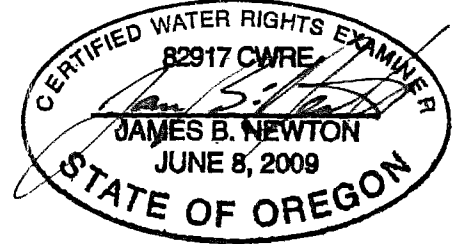


718

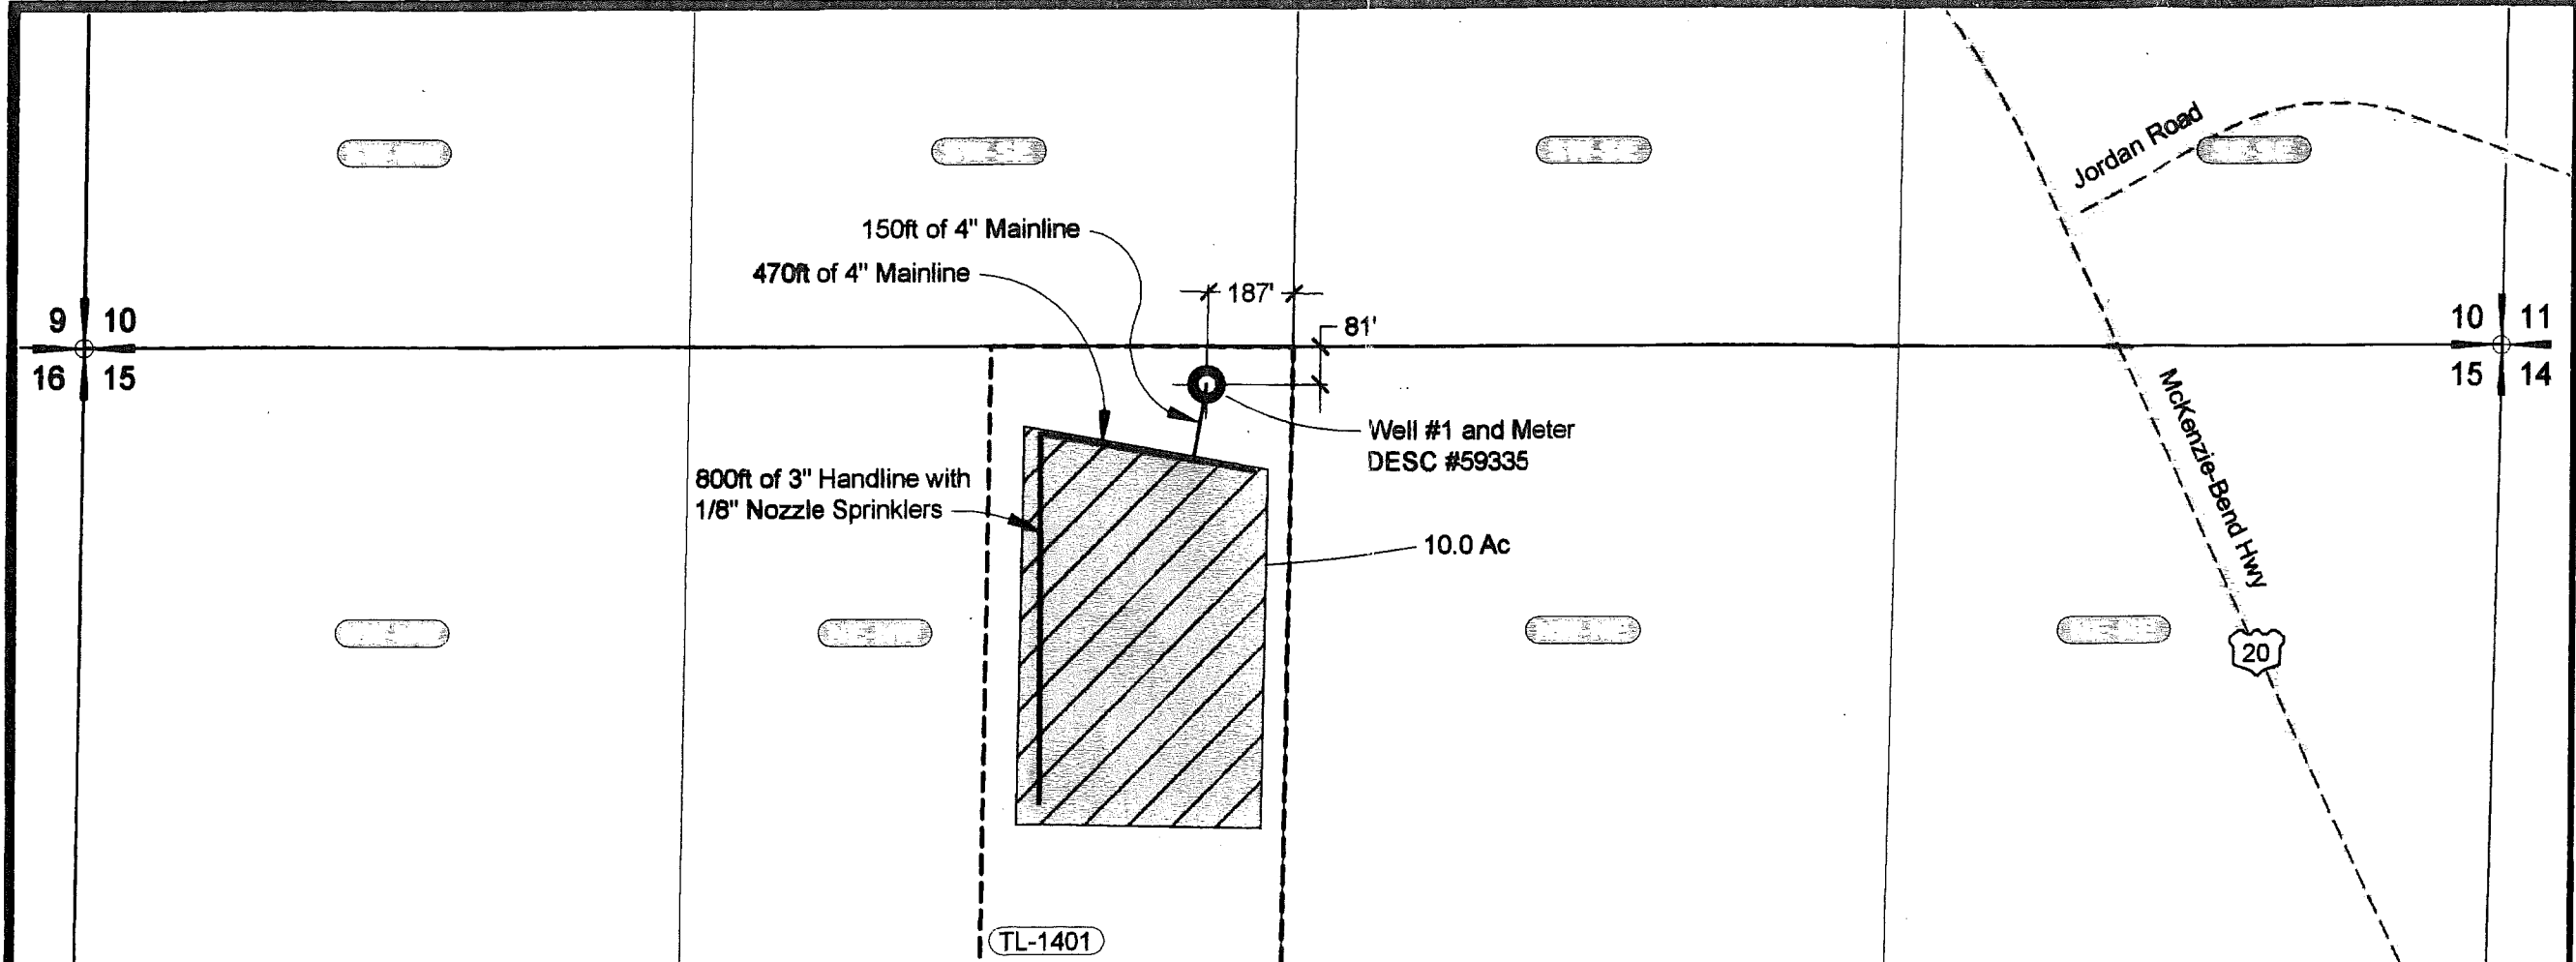


EXPIRES: 12-31-2012  
RENEWS:

RECEIVED BY CWRD

OCT 01 2012

SALEM, OR

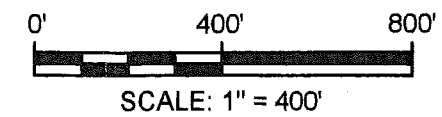



**T-10761**  
**COBU - PLACE OF USE MAP**  
Located in NE¼ - NW¼ of Section 15, T15S, R10E, W.M.  
Tax Lot 1401, Deschutes County, Oregon

Summary Table - POU

Place of Use	Acres	Tax Lot	¼-¼
T.15S., R.10E., Sec 15	10.0	1401	NE-NW

**EXPLANATION**

-  POU - Irrigated Acres
-  Well #1, OWRD Well Log ID DESC\_59335



**NOTES**

1. This map was prepared for the purpose of identifying the location of water rights only and is not intended to provide legal dimensions or locations of property ownership lines.

**NEWTON CONSULTANTS INC.**  
Earth, Water and Rock Specialists  
PH: 541 804-6660 Fax: 541 804-6661

DESIGNED BY: J. Newton

DRAWN BY: S. Schenck

DATE:

FEB 2012

PROJECT NO. 418-160

FIGURE

**T-10761 COBU - Place of Use Map**  
William Smith Properties, Inc.  
Sisters, Deschutes County, Oregon

COBU MAP # 718