



SCALE: 1"=400'

CLAIM OF BENEFICIAL USE MAP FOR CITY OF PORTLAND PARKS & RECREATION TRANSFER T-10102

WESTMORELAND PARK
SITUATED IN E 1/4, SECTION 23,
AND IN W 1/4, SECTION 24,
T1S, R1E, W1M.
CITY OF PORTLAND
MULTNOMAH COUNTY, OREGON
AUGUST, 2012

NE1/4, NE1/4, SEC. 23

5.01 Ac.

1.19 Ac.

NW1/4, NW1/4, SEC. 24

SE1/4, NE1/4, SEC. 23

6.43 Ac.

SE 22ND AVE.

SE MCLOUGHLIN BLVD.

LEGEND:

- SECTION LINE
- 1/4 1/4 SECTION LINE
- PROPERTY LINE
- AREA OF USE - IRRIGATION (HATCH ANGLE CHANGES BY SECTIONAL SUBDIVISION)


DIVERSION PUMP AND METER IS LOCATED 269' N AND 191' W OF THE E 1/4 SEC. 23

20 HP IRRIGATION PUMP IS LOCATED 244' N AND 203' W OF THE E 1/4 SEC. 23

POINT OF DIVERSION AND FISH SCREEN IS LOCATED 249' N AND 264' W OF THE E 1/4 SEC. 23

SW1/4, NW1/4, SEC. 24

EXISTING CASTING POND (BULGE IN SYSTEM) LOCATED WITHIN TAX LOT #R991240720

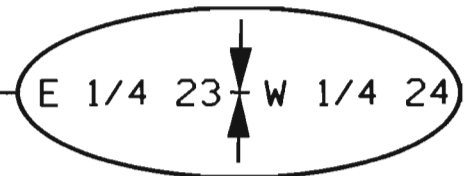

SE LAMBERT ST.

NE1/4, SE1/4, SEC. 23

2.95 Ac.

NW1/4, SW1/4, SEC. 24

CRYSTAL SPRINGS CREEK


RECEIVED BY OWRD

AUG 23 2012

SALEM, OR

10.32 Ac.

SE NEHALEM ST.

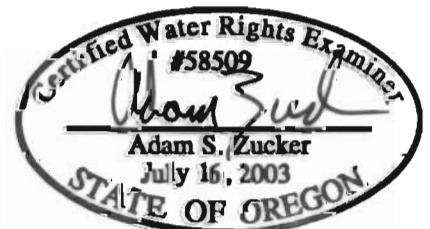

Expiration Date: 6-30-14

THIS MAP IS TO IDENTIFY A PROPOSED WATER RIGHT LOCATION. IT IS NOT TO BE USED TO LOCATE PROPERTY BOUNDARIES.