T.6S. R.5W. W.M.

POLK COUNTY, OREGON

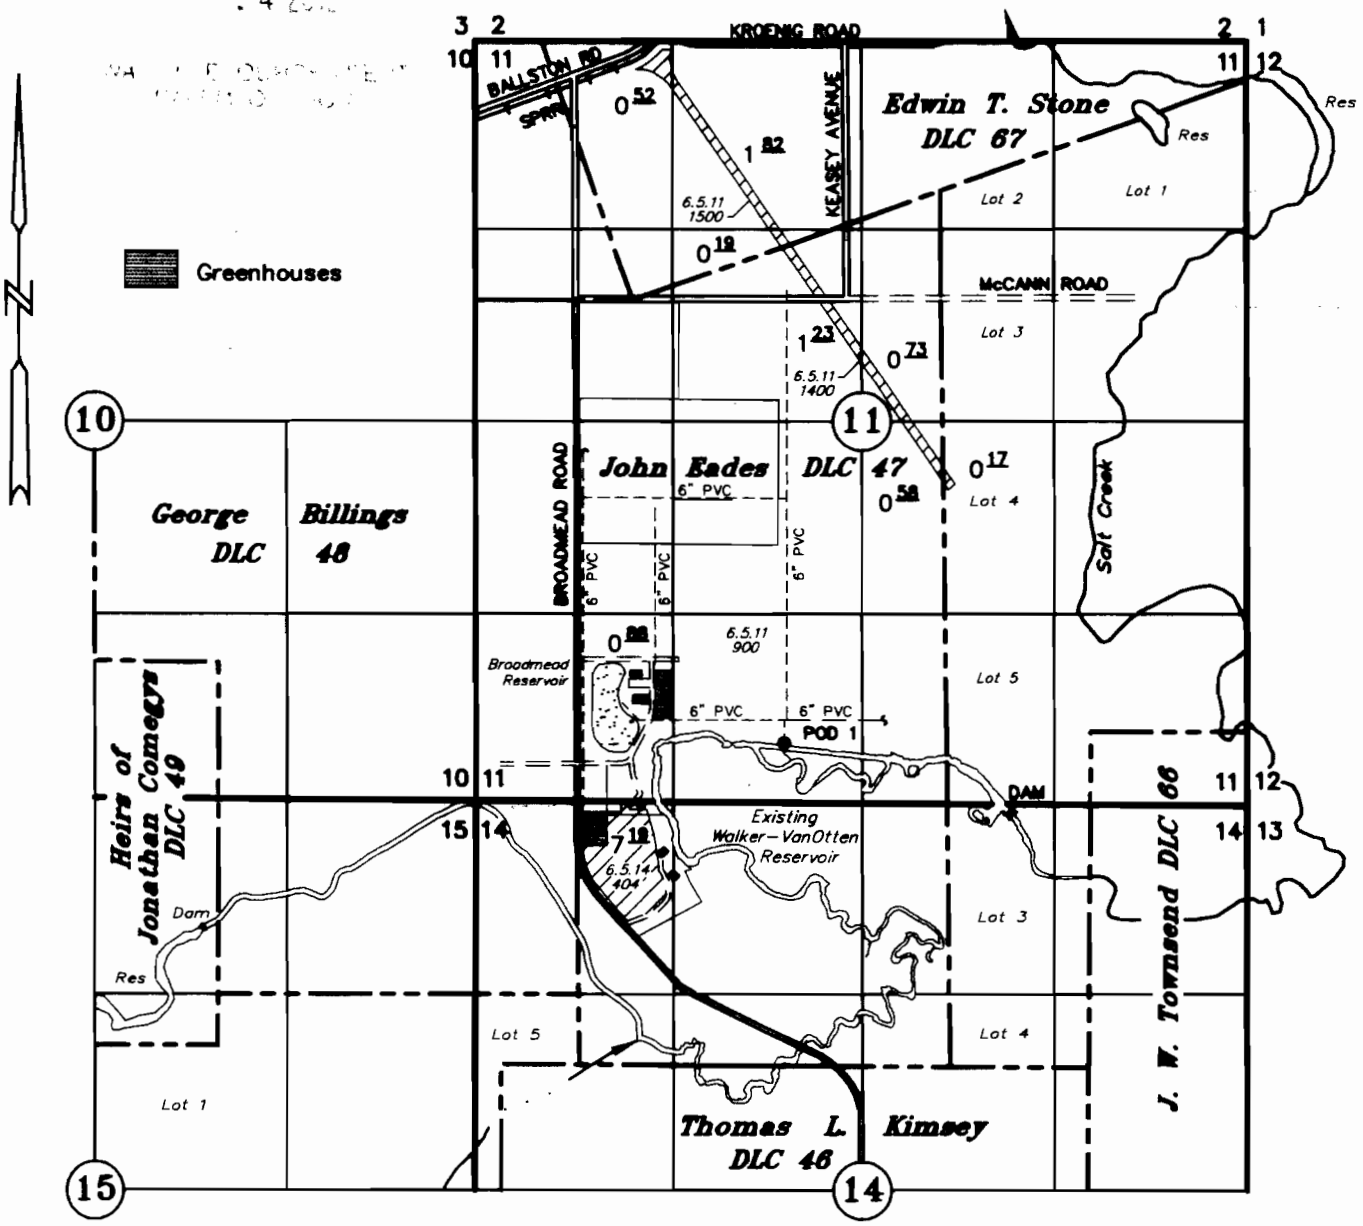

POD 1: 2228' NORTH AND 1405' EAST OF SW COR JOHN EADES DLC 47
with approved fish screen on end of foot valve and meter at pump

TAX LOTS
6 5 11 900
6 5 11 1400
6 5 11 1500
6 5 14 404

CLAIM OF BENEFICIAL USE

UNDER

Application No. T-10473

BROADMEAD, LLC

August 27, 2010

SCALE 1" = 1320'

NOTE: This map is for the purpose of identifying the location of water rights and has no intent to dimension or locate property ownership lines.

Certified Water Right Examiner
#206 WRE
Corbey Beatwright
May 30, 1980
STATE OF OREGON

Renewal Date: 12-31-2013